

FORM 51 5M 11-44 PETROL

Section 27 Township 34 Range 39W
Well No. #2 ~~#1~~ Cunningham
Company Harrington & Marsh

NORTH

O

SOUTH

KANSAS Stevens County

Sec. 27 Twp. 34 R. 39-W

Well No. #2 ~~#1~~ Cunningham Farm.

Harrington & Marsh Company


Hugoton

140 Ft. from N. Line

Ft. from S. Line

140 Ft. from E. Line

Ft. from W. Line

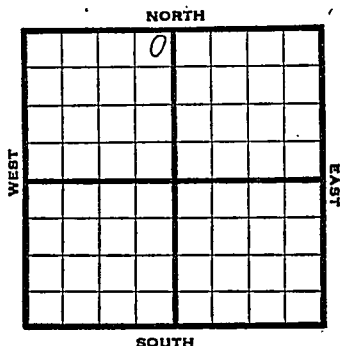

NE NW

1946 3293

REPORT

6/19	Location
6/26	"
7/3	"
7/9	"
7/16	"
7/23	10" @ 600' Drlg 1050'
7/30	7" @ 2620' TD 2630, RUST
8/6	Drlg 2840'
8/13	TD 2783-189' of 5" Perf liner @ 2783'
8/20	15000 acid
8/27	" "
9/5	" "
9/10	" "
9/18	7" @ 2620' - 189' of 5" Perf liner : 2783' TD 2783' Acid 15,000 Gas 30,400,000 RPR 354#

COMPLETED

KANSAS Kansas Pool Name Hugoton
No map
 Map No. _____ Sec. 27 Twp. 34 R. 39W

Well No. 1 Cunningham

Harrington & Marsh Company

FIRST REPORT

Contractor

NE NW

SECTION PLAT

		0	

140 Ft. from N. Line

_____ Ft. from S. Line

140 Ft. from E. Line

_____ Ft. from W. Line

Stevens County

Location X

Rig up _____

Drilling and Remarks:

RECORD

Cased _____ in., _____ ft.

Sand _____

Gas _____

Oil _____

Total Depth _____

PRODUCTION

1st 24 hrs. Nat. _____

1st 24 hrs. after shot _____

Gas _____ Cu. Ft.

Dry Hole _____

Abandoned _____

Date

JUN 19 1946 19

S. J. LEWIS

Scout

Misc. Small Maps _____
Cards Garth _____
Tracing ✓ _____
France Map ✓ _____
Scarborough Map ✓ _____
Pierce Map ✓ _____
Cecological Dept. _____
Pierce Plat Book _____

Kansas Pool Name HugotonMap No. _____ Sec. 27 Twp. 34 R. 39WWell No. 2 CunninghamHarrington & Marsh

Company

CORRECTION

Contractor

NE NW

SECTION PLAT

140 Ft. from N. Line

_____ Ft. from S. Line

140 Ft. from E. Line

_____ Ft. from W. Line

Stevens Cou ty

Location _____

Rig up _____

Drilling and Remarks:

Reported as

#1 Cunningham

RECORD

Cased _____ in. _____ ft.

Sand _____

Gas _____

Oil _____

Total Depth _____

PRODUCTION

1st 24 hrs. Nat. _____

1st 24 hrs. after shot _____

Gas _____ Cu. Ft.

Dry Hole _____

Abandoned _____

Date

JUL 24 1948

19

S. J. LEWIS

Scout

Misc. Small Maps

Cards *Joseph*

Tracing *L*

France Map *L*

Scarborough Map *X*

Pierce Map *X*

Geological Dept. _____

Pierce Plat Book _____

KANSAS

Kansas


Pool Name Hugoton PoolMap No. _____ Sec. 27 Twp. 34 - R. 39WWell No. 2 CunninghamHarrington & Marsh

Company

COMPLETED

Contractor

NE NW

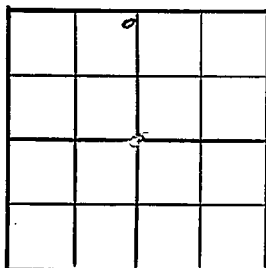E 1/32 93
SECTION FLAT140 Ft. from N. Line Ft. from S. Line140 Ft. from E. Line Ft. from W. LineStevens County

Location _____

Rig up _____

Drilling and Remarks: *7" 2620**189' 8" 15" 22' 1/2" 2783**15000 cu. ft.**30,400,000 Gas**344 # R/B***RECORD**

Cased _____ in. _____ ft.

Sand _____

Gas _____

Oil _____

Total Depth 2783**PRODUCTION**

1st 24 hrs. Nat. _____

1st 24 hrs. after shot _____

Gas _____ Cu. Ft.

Dry Hole _____

Abandoned _____

Date

SEP 1 8 1946

19

S. J. LEWIS

Scout

Check spot our
records show
his well in
another spot
advised
Sam

Misc. Small Maps

Cards Frank

Tracing L

France Map C

Scarborough Map C

Pierce Map C

Geolog. Dept. _____

Pierce Flat Book