


KANSAS

Morton

FORM 51 25M 3-49 PETROL

Section 27 Township 34 Range 40-WWell No. #1-27 MillemanCompany Panhandle Eastern

NORTH

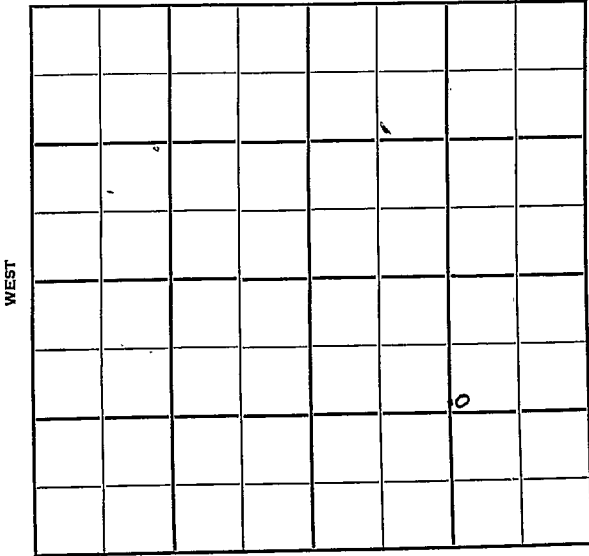

SOUTH

Morton

KANSAS

Sec. 27 Twp. 34 R. 40W 

Well No. #1-27 Milleman Farm

Panhandle Eastern Company

Contractor

Ft. from N. Line

1370'


Ft. from S. Line

1270'

Ft. from E. Line

Ft. from W. Line

SW NE SE

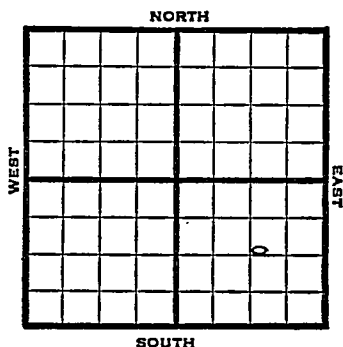

1950

Elev 3369

REPORT

5/31

Location

7/12

10" @ 483

8" @ 2535

TD 2720

Hol 2480

Win 2607

19000 total acid

Comp 13,241,000

Completed

COMPLETED

Krider 2539

Ft Riley 2689

Map No. _____ Sec. 27 Twp. 34 R. 40WWell No. 1-27 MillemanPanhandle Eastern Company_____
SW NE SE Contractor

SECTION PLAT

Ft. from N. Line1370 Ft. from S. Line1270 Ft. from E. Line_____
Ft. from W. Line

	FIRST	REPORT	
			o

Morton

Location _____

Rig up _____

Drilling and Remarks:

RECORD

Cased _____ in., _____ ft.

Sand _____

Gas _____

Oil _____

Total Depth _____

PRODUCTION

1st 24 hrs. Nat. _____

1st 24 hrs. after shot _____

Gas _____ Cu. Ft.

Dry Hole _____

Abandoned _____

Date

MAY 31 1950

19

J. E. TYRA Scout

Kansas Hugoton Pool

Map No. _____ Sec. 27 Twp. 34 R. 40WWell No. 1-27 Milleman

Panhandle Eastern

Company

Contractor


SW NE SE

E1. 3369
SECTION PLAT

_____ Ft. from N. Line

1370 Ft. from S. Line1270 Ft. from E. Line

_____ Ft. from W. Line

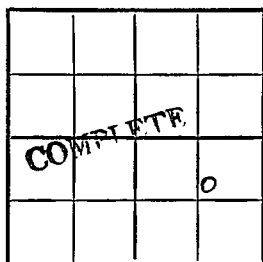

Morton County

Location _____

Rig up _____

Drilling and Remarks:

10" C 483

7" C 2535

TD 2720

Hel. 2480

Kridner 2539

Win. 2607

Ft. Riley 2689

19000 total acid

Date Comp. 13,241,000

RECORD

Cased _____ in., _____ ft.

Sand _____

Gas _____

Oil _____

Total Depth 2720

PRODUCTION

1st 24 hrs. Nat. _____

1st 24 hrs. after shot _____

Gas _____ Cu. Ft.

Dry Hole _____

Abandoned _____

JUL 12 1950

19

J. F. TYRA Scout