

Barber


DX 78-1

KANSAS

Section 28 Township 34 Range 12W

Well No. #1 Graves

Company The Atlantic Ref. Co.

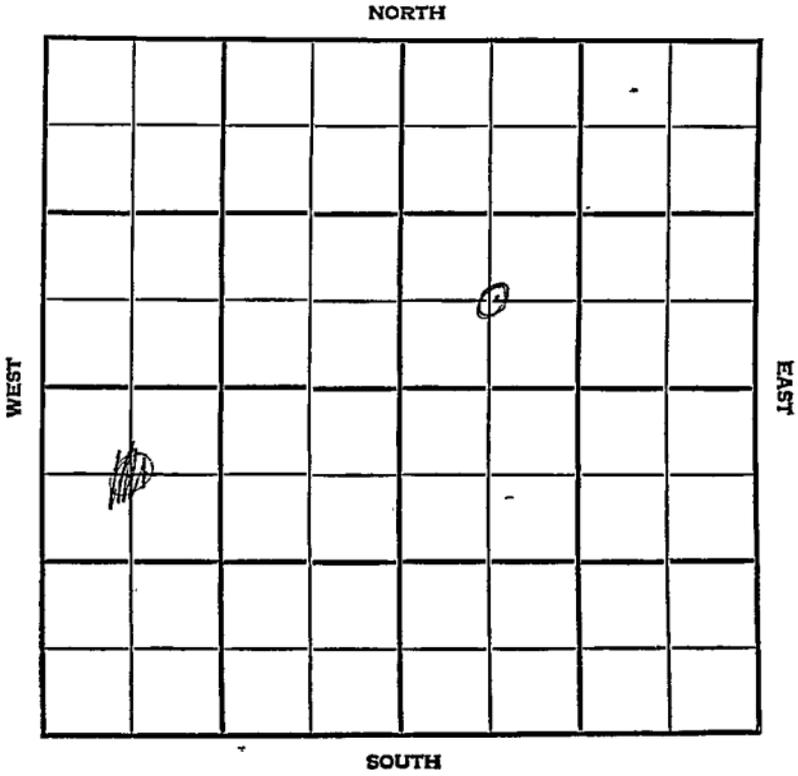

County Barber Elev. _____
 Sec. 28 Twp. 34 Rgs. 12W
 Company The Atlantic Ref. Co.
 Farm Name Graves No. 1

TOPS	DEPTH	LOG	DATUM
Anb.			
Tp.			
H.			
Tr.			
Dg.			
Bl.			
L.			
K.C.			
B.K.C.			
Ce.			
C.			
M.			
M.			
K.			
Mz.			
Mo.			
V.			
S.			
S.			
A.			
R.			
PE.			
G.			
T.D.			

Loc. in Sec. _____

C SW NE 60'

So. of

Geol. _____

Contr. _____

Musgrove Tool

Pool

Hardner



Date Comm. _____

MIRT

Co.

1st

No.

Sec.

T.

R.

County Barber Elev. 1159
 Sec. 28 Twp. 34 Rge. 12W
 Company The Atlantic Ref. Co.
 Farm Name Graves No. 1

TOPS	DEPTH	LOG	DATUM
Anb.			
Tp. <u>E19</u>	<u>3600</u>		
H.	<u>3810</u>	<u>3811</u>	
Tr.		<u>3843</u>	
Dg.		<u>3875</u>	
BL			
L.	<u>4063</u>	<u>4068</u>	
K.C.			
B.K.C.			
Ce. <u>-c9</u>	<u>4710</u>	<u>4709</u>	
C.			
M. <u>cherty</u>	<u>4738</u>	<u>4733</u>	
M.			
K.			
Mz.			
Mo.			
V.			
S.			
S.			
A.			
R.			
PC.			
G.			
TD. <u>4826</u>	<u>4813</u>		<u>1</u>

Loc. in Sec. C SW NE 60'
 So. of _____
 Geol. _____
 Contr. _____
Musgrove Tool
 Pool _____
Hardner

COMPLETE
 JAN 30 '57

Date Comm. NOV 31 '56 10-23-56 8 5/8
248/200 3417 NOV 7 '55
DST 4696-4785 op 36" gas/10"
TSTM est 10 MCF net 125'
GCM FP 65-80' BHP 1685/30"
W.O.O. NOV 13 '56 5 1/2 @ 4826/200 NOV 21 '56
CO ~~28/4720-27~~ CO 28/4720-27
36/4739-48 56/4754-78 56
Frac 20x20 est 10 to 15 M/11
CFG NOV 28 '56

Flow 9 1.840 MCFG + Load
 + 15/14" ch. DEC 5 '56 ga 5.340
 MCFG + Ld 1/2" ch. TP

1008 # CP 1382 # 5.1, DEC 12 '56

D.L. 17 '56

DEC 25 '56

JAN 2 '57

JAN 5 '57

JAN 15 '57

JAN 23 '57

CSD est up

Flow @ 16 Mill CFGPP

SITP 1450 SICP 1467 JAN 30 '57

complete ↑