

Section 28 Township 34 Range 17WWell No. 1 JacksonCompany G-M-R & Natural Gas & Oil

NORTH

WEST	0							

Comanche

KANSAS

SEC.	TWP.	R.
28	34	17 W

WELL NO.

1 Jackson FARM

COMPANY

G-M-R & Natural Gas & Oil

CONTRACTOR

G-M-R


Wildcat

330 Ft. from N. Line

- Ft. from S. Line

- Ft. from E. Line

330 Ft. from W. Line

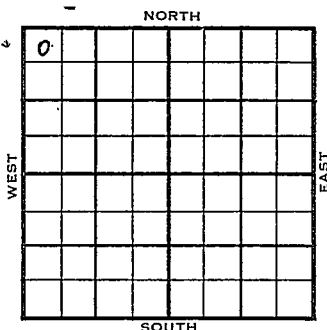

NW NW NW
Shell FO & DHM

	ELEVATION	REPORT
1954	1804	
		4500' Arb. Test
5/26	MIR	
6/2	15" @ 231'	
	Drlg. 882'	
6/9	8" @ 2360'	
	rlg.	
7/21	" 5255	
8-11	Spdg 5-31-54	
	D&A	
	TD 6500	
	15" @ 231	
	Win. 2486 Fr. Riley 2560	
	DST 2355-2525 open 1 hr. Rec. 270' sw	
	8" 2360.	
	Elgin 4147	
	DST 4146-90 open 1 hr. Rec. 1020' sw	
	2000#	
	Heeb 4278 Tor. 4303 Doug. 4382	
	DST 4373-4450 open 1 hr. Rec. 20' mud	
	0#	
	Lans. 4490	
	DST-4580-4669 open 1 hr. Rec. 1428' sw	
	1750#	
	BKC 4860 Marm. 4975 Miss. 5240	
	DST 5242-59 open 1 hr. Rec. 30' mud 0#	
	DST 5258-96 open 1 hr. Rec. 48,000 gas	

DX-78

OVER

1954
8-11

Information brought forward

100' gcm 1070#

DST 5390-5438 open 1 hr. Rec. 350'
so & gcm 1770#

Cowley 5591 Chat sh. 5896 Viola 5909

DST 5884-5940 open 1 hr. Rec. 50'
mud

DST 6146-6204 open 75 min. Rec. 3140'
sw 2380# Arb. 6294

TD 6500

Schlumberger: Tops Lans. 4500 Miss.--

5250 Viola 5906 Simp. 6104 Arb. 6310

✓ DST 6420-6500 open 1 hr. Rec. 1980' sw
2250#

D&A

ABANDONED

County **Gemanche** State **Kansas**

Sec. 28 (Blk. Twp.) 34 (Sur. Rge.) 17W Map No.

Operator C-M-R & Natural Gas & Oil

Well No. 7 Farm Jackson

Elev.	Location	TIME TIME TIME
-------	----------	----------------

FIRST REPORT

330 Ft. From N Line NW

330 Ft. From ~~the~~ Line Quarter

1st. Report **MAY 26 1954**

Completion 4500* Arb. test

Remarks Shell FO & DEM

G-M-R - Contr.

Spudding Date

Drig. Data _____ Wt Locat: _____

W T R

Scout Cards

Land Small Map

Land Wall Map

Tracings

France Map


Pierce Map

Misc.

MAY 27 1954

Orig. Data

County Comanche State Kansas
 Sec. 28 (Blk. 34) (Sur. 17W) Map No.
 Operator G-M-R & Natural Gas & Oil
 Well No. 1 Farm Jackson
 Elev. 1804 Location NW NW NW

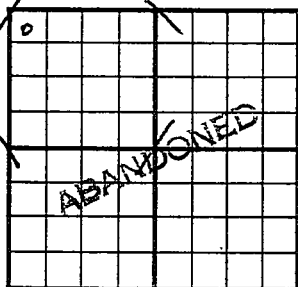

330 Ft. From N Line NW
330 Ft. From W Line Quarter

1st. Report

Completion AUG 11 1951

Remarks Wildcat

G-M-R - Contr.

Spudding Date 5-31-54

Drlg. Data D & A TD 6500

15" @ 231 Win. 2486 Ft. Riley 2560

DST 2355-2525 open 1 hr. Rec. 270' sw

8" @ 2360 Elgin 4147 DST 4146-90

open 1 hr. Rec. 1020' sw 2000#

Heeb. 4278 Tor. 4303 Doug. 4382

DST 4373-4450 open 1 hr. Rec. 20' mud

0# Lans. 4490 DST 4580-4669 open 1 hr.

Rec. 1420' sw 1750# B KC 4860

Marm. 4975 Miss. 5240 DST 5242-59

open 1 hr. Rec. 30' mud 0#

DST 5258-96. open. 1 hr. Rec. 48,000 gas

100' gcm. 1070# DST 5390-5438 open 1 hr

Rec. 350' so & gcm 1770# Cowley 5591

Chat sh. 5896 Viola 5909 DST 5884-5940

AUG 17 1954

Drig. Date
open 1 hr. Rec. 501. mtd. 6146-6204
open 75 min. Rec. 2140 mtd. 6146-6204
Arb. 6294 TD 6500 SCHILMIDT TOPS
Lans. 4500 Miss 5250
Stmp. 6104 Arb. 6310 Scout mtd. 6420-6500
open 1 hr. Arb. 6380 SW 2250#
D & A