

Seward

KANSAS

28

34S

33W

SECTION _____ TOWNSHIP _____ RANGE _____

#1 Black "B"

WELL NO. _____

Graham-Michaelis


COMPANY _____

NORTH

C SE $\frac{1}{4}$

WEST

EAST

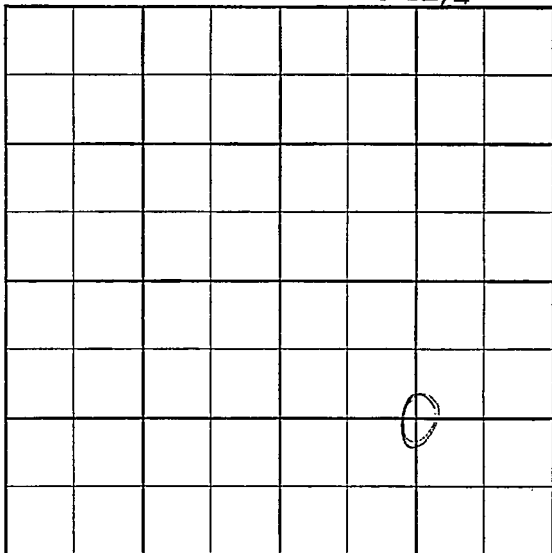

SOUTH

35

S-513-A

CO. Seward ELEV. _____
SEC. 28 TWP. 34 RGE. 33W
COMPANY Graham-Michaelis NO. 1

FIRST REPORT

OCT 30 '31

FARM Black "B"

Pan. Am. FO

LOC. C SE/4

GEOL. _____
CONTR. Co. Tools #5
POOL Hugoton
SPUD _____

MIRT

CO. 1
LSE.
NO.
SEC.
TWP.
RGE.

S-313-A

CO. Seward

ELEV. 28270

DEC 4 '57

CO.

SEC. 28

TWP. 34

RGE. 33W

COMPLETE

COMPANY Graham-Michaelino. 1

FARM Black "B"

Pan. Am. FO

LOC. C SE 1/4

LSE.

GEOL.

CONTR. Co. Tools 118 3H

POOL Hugoton

SPUD 10-31-57

8" 633/300 ϕ 2458

NO.

SEC.

TWP.

RGE.

MIRT NOV 6 '57

TD 2731

log 5 1/2 2730/300 Hem

2597 Vkr id 2630 Lkr id

2672 Win 2718 WOCT

NOV 20 '57 \$100 N gas 32/2630

-38 2672 42 prep

NOV 27 '57 6 ga 5.40 mcf Dwy

DEC 4 '57 CO 2724 8/2719

NS 3) \$100 g w ph NO gas

59 32/2630-38 40/2682

-92 frac 6x3 ga 5.40c

mcf 20" op Fl

12.339 mcf RP355

K 2630-92