


Section 28 Township 34 Range 33W

Well No. #1 Black Gas Unit "B"

Company Stanolind

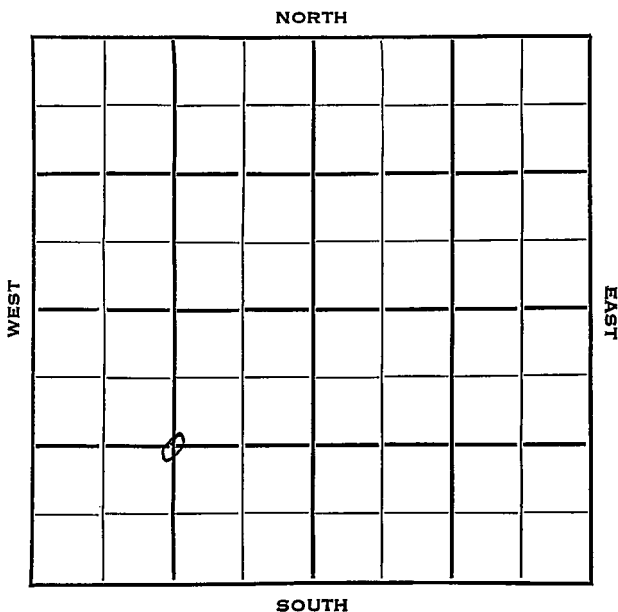

Seward KANSAS

SEC.	TWP.	R.
28	34	33W ✓

WELL NO.

1 Black Gas Unit "B"

FARM

COMPANY

Stanolind

CONTRACTOR

Moran


Hugoton Pool

Ft. from N. Line

1320 Ft. from S. Line

Ft. from E. Line

1320 Ft. from W. Line

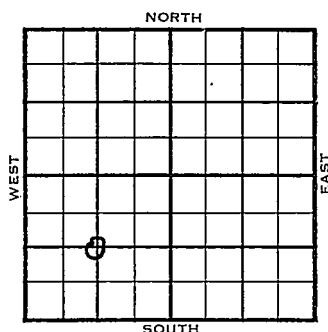

C SW/4

	ELEVATION	REPORT
1954	2845'	

3/24 Spud 3-17-54
10" @ 550'
Drlg. 2350'


3/31 Drlg 2525'
4/7 RTD 2693'
Her 2626', Kr. 2693'
5" @ 2657'

4/28 Spud 3-17-54 Gas well TD 2693
10" @ 550 Her. 2626 Kri. 2693
TD 2693 5" @ 2657 CO to 2693
2500 A 18/2620-29 42/2638-45
2000 A 1½ MCFG 7000 A 4000 A
6000 A Comp. 5,901,000 gas. 375#

COMPLETED

J. G. McGEHEE

County Seward State Kansas
 Sec. 28 (Blk. 34) (Sur. 33W) Map No. 33W
 Operator Stanolind
 Well No. 1 Farm Black Gas Unit "B"
 Elev. 2845 Location C SW/4

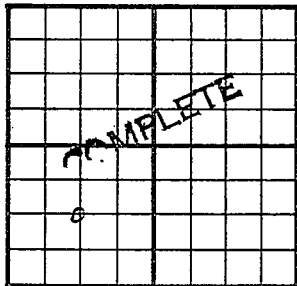

1320 Ft. From S Line SW
1320 Ft. From W. Line Quarter
 Ist. Report
 Completion APR 28 1954
 Remarks Hugoton Pool
Moran - Contr.
 Spudding Date 3-17-54

Drig. Data Gas well TD 2693
10" @ 550 Her. 2626 Kri. 2693
TD 2693 5" @ 2657 CO to 2693
2500 A 18/ 2620-29 42/ 2638-45
2000 A 1½ mcf/g 7000 A 4000 A 6000 A
Comp. 5,901,000 gas 375#

J. G. McGEHEE