


Seward **KANSAS**Section 28 Township 34 Range 33WWell No. #1 EmrieCompany Cities Service

NORTH

WEST

EAST

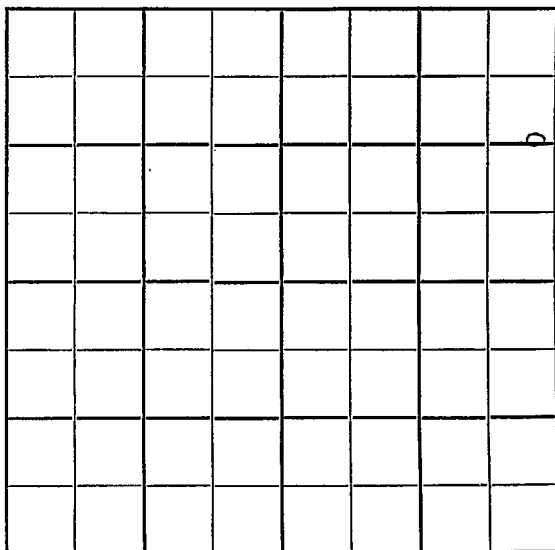

SOUTH

Seward

KANSAS

Sec. 28 Twp. 34 R. 33W ✓

Well No. #1 Elmerie Farm

Cities Service Company

Barbour Drlg. - Contr. Contractor

Hugoton Pool


1250' Ft. from N. Line

 Ft. from S. Line

150' Ft. from E. Line

 Ft. from W. Line


C E L E $\frac{1}{2}$ NE

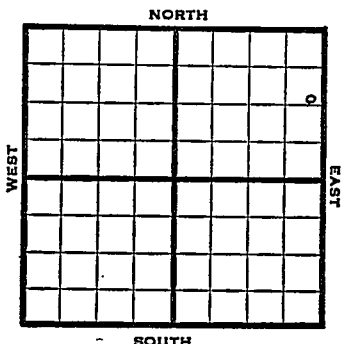

1950 Elev. 2827 REPORT

11/29 Spud 11-25-50
8" @ 680'
Drlg. 1555'

1951
2/7 Spud 11-25-50
Gas well TD 2755
8" @680 Her. 2598 Krider 2624
Win. 2708
5" @2754 TD 2755
40/ 2706-14 130/ 2654-80 40/2622-30
500/ 2598-2608 11500 A
Comp. 12,500,000
COMPLETED

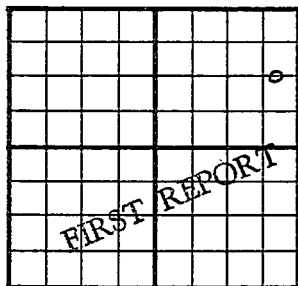County Seward State KansasSec. 28 (Blk. Twp.) 34 (Sur. Rge.) 33W Map No.Operator Cities ServiceWell No. 1 Farm EmrieElev. Location C E I. E $\frac{1}{2}$ NE1250 Ft. From N Line NE150 Ft. From E Line Quarter1st. Report NOV 29 1950


Completion

Remarks

Barbour Drlg. - Contr.Spudding Date 11-25-50Drlg. Data Hugoton Pool8" @ 680 drlg. 1555

J. E. TYRA

County Seward State Kansas
 Sec. 28 (Blk. 34 (Sur. 33W Map No.
 (Twp.) (Rge.)
 Operator Cities Service
 Well No. 1 Farm Emrie
 Elev. 2827 Location C E L E $\frac{1}{2}$ NE

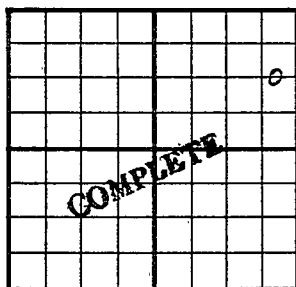

1250 Ft. From N Line NE
150 Ft. From E Line Quarter

1st. Report

Completion FEB 7 1951

Remarks Hugoton Pool
Barbour Drlg. - Contr.

Spudding Date 11-25-50

Drlg. Data Gas well TD 2755

8" @ 680 Her. 2598 Krider 2624

Win. 2708 5" @ 2754 TD 2755

40/ 2706-14 130/ 2654-80 40/ 2622-30

500/ 2598-2608 11500 A Comp. 12,500,000

J. E. TYRA