


KANSAS

FORM 51 25M 3-49 PETROL Seward

Section 28 Township 34 Range 34W

Well No. #1 Gartung

Company Hugoton Plains

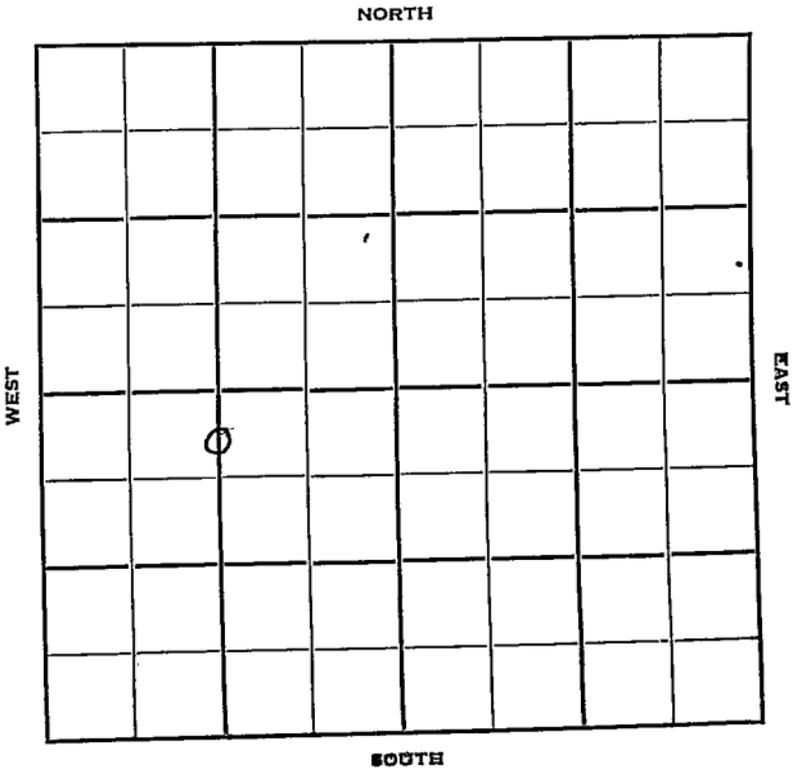

Sec. 28 Twp. 34 R. 34W

Well No. #1 Gartung Farm

Hugoton Plains Company

Hugoton Pool Contractor


Ft. from N. Line

2440' Ft. from S. Line

Ft. from E. Line

1320' Ft. from W. Line

C N L N $\frac{1}{2}$ SW

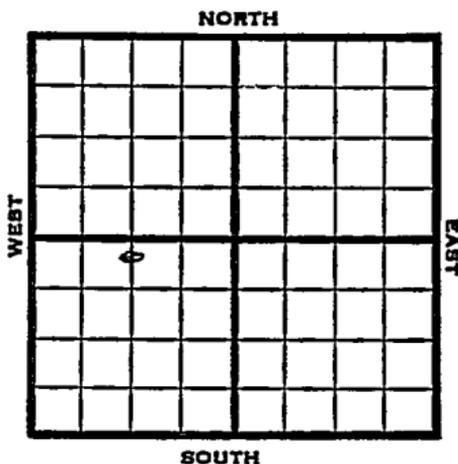

1951

Elev. 2930' REPORT

8/8

Spud 8-3-51
10" @ 713
Drlg. 2181'

9/26

Spud 8-3-51
Gas well TD 2728' 10" @ 713
7" @ 2726 TD 2728' Hol 2582'
Her. 2645' Kri. 2677'
30/2645-50 60/2654-64 60/2678-
84 96/2704-20 12,000 A
Comp. 1,200,000 gas

COMPLETED

County Seward State Kansas

Sec. 28 (Blk. 34) (Sur. 34W) Map No. 34W

Operator Hugoton Plains

Well No. 1 Farm Gartung

Elev. 2930 Location C N L N $\frac{1}{2}$ SW

2440 Ft. From S Line SW

1320 Ft. From W Line Quarter

1st. Report _____

Completion SEP 26 1951

Remarks Hugoton Pool

Spudding Date 8-3-51

Drlg. Data Gas well TD 2728

10" @ 713 7" @ 2726 TD 2728

Hol. 2582 Her. 2645 Kri. 2677

30/ 2645-50 60/ 2654-64 60/ 2678-84

96/ 2704-20 12000 A Comp. 1,200,000 gas