

DX 78-1

Morton

KANSAS

28

34

43W

Section _____ Township _____ Range _____


Well No. #2 Roll "D" _____

Company Cities Service _____

NORTH

WEST

EAST

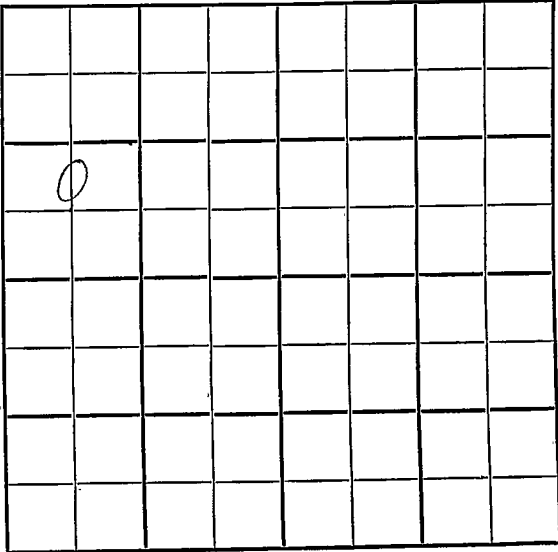

SOUTH

County Morton Elev. _____
 Sec. 28 Twp. 34 Rge. L3W
 Company Cities Service
 Farm Name Roll "D" No. 2

TOPS	DEPTH	LOG	DATUM	Loc. in Sec.
Anh.				C N $\frac{1}{2}$ SW NW
Tr.				
H.				
Tr.				
Dg.				
BL.				
L.				Geol. _____
K.C.				Contr. _____
B.K.C.				
Ce.				
C.				
M.				Pool _____
M.				Greenwood
K.				
Mz.				
Mo.				
V.				
S.				
S.				
A.				
R.				
Pe.				
G.				
T.D.				

JAN 9 1957	
FIRST REPORT	

Date Comm.

Location

~~34~~

34

County	Morton	Elev.	3502
Sec.	28	Twp.	34
Company	Cities Service	Rge.	13W
Farm Name	Roll "D"	No.	2

TOPS	DEPTH	LOG	DATUM	Loc. in Sec.
Anb.				C N ¹ / ₂ SW NW
Ip.		2713		
H.		3028		
Tc.				
Dg.				
Bl.				
L.		3145		Geol.
K.C.				Contr.
BKC.				
Ce. - Marm		3427		
Ce.		3612		
M. - MWSH		4082		
M. - Pardy		4161-73		Pool
K.				Greenwood
Mz.				
Mo.				
V.				
S.				
S.				
A.				
R.				
Pe.				
G.				
TD.	4240			COMPLETE

Date Comm.

Location	JAN 15 '57	JAN 28 '57	JAN 30 '57
1- 28- 57	FEB 11 '57	8 ⁵ / ₈	1216/600
3037	FEB 13 '57	DST 4161-80	1 hr
6 1/3"	TSTM	4180'	oil no/w
FP 320-720	DHP	1146/15	
5 1/2	4239	1200 WOC	FEB 20 '57 CO
4186	24/	4162-68	Flowed 40
130 in.	2 hrs	Rnq. T69	FEB 27 '57
MAR 3 '57	MAR 13 '57	MAR 20 '57	MAR 27 '57
APR 10 '57	PH P.	178 BOPD	170/Wt.