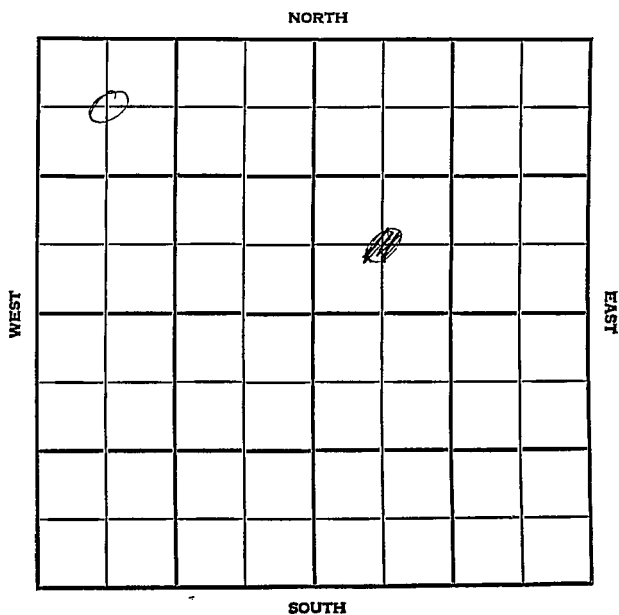


Section 28 Township 34 Range 43WWell No. #1 Roll "D"Company C.S.O.

County Morton Elev. _____
 Sec. 28 Twp. 34 Rgs. 43W
 Company C. S. O.
 FarmName Roll "D" No. 1

TOPS	DEPTH	LOG	DATUM	Loc. in Sec.
Anh.				C NW NW
Tp.				
H.				
Tr.				
Dg.				
Bl.				
L.				Geol. _____
K.C.				Contr. _____
B.K.C.				
Ce.				
C.				
M.				
M.				Pool _____
K.				Interstate _____
Mz.				
Me.				
V.				
S.				
S.				
A.				
R.				
PE.				
G.				
T.D.				

Date Comm. spd. 11-1-56

13" @ 120 w/150, 8" @ 1184 w/600, WOC

34

County	Norton	Elev.	3483	Co.
Sec.	28	Twp.	34	
Company	C. S. O.	Rge.	43W	
FarmName	RoM "D"	No.	1	

TOPS	DEPTH	LOG	DATUM	Loc. in Sec.	Lse.
Anh.				C NW NW	
TP.		2674			
H. CSO LSG		2905			
Tr. HK		2988			
Dg. LSG		3104			
Bl. Marm		3386			
L. MWSH		4035		Geol.	
K.C. " 2d		4110-570		Centre	
BKE-CE		3572			
Ce.					
C.					
M.					
M.				Pool	
K.				Interstate	
Mz.					
Me.					
V.					
S.					
S.					
A.					
R.					
PE.					
G.					
TD.	4175				

Date Comm. spd. 11-1-56

13" @ 120 w/150, 8" @ 1184 w/600, WOC NOV 13

2575 NOV 21 '56 DST 4080-4101

30" 5' Md BHP 0/15 DST

4128-74 45" 6/3 1/2" ga 228

MCF 15" oil in 20" FP 960

-1100 BHP 1320/25" 5 1/2 e

4195/240 NOV 28 '56 WOC DEC 5 '56 CO

4154 40/4128-38 F/W 70 B0 2 1/2

In 1/2" ch F/W 70 B0 1 1/2 3/4"

4" DEC 12 '56

C 10 50

DEC 26 '34

JAN 7 '35

JAN 9 "

JAN 11 "

P. 4 Bopk in 4 hrs P.

32 Bo in 9 hrs P. 52.69

Bo in 8 hrs 23.57 Ph P.

158 Bopd no/wh

graw 39.5°