


Section 28 Township 34 Range 43 W

Well No. # 1 Roll "A"

Company Cities Service Oil

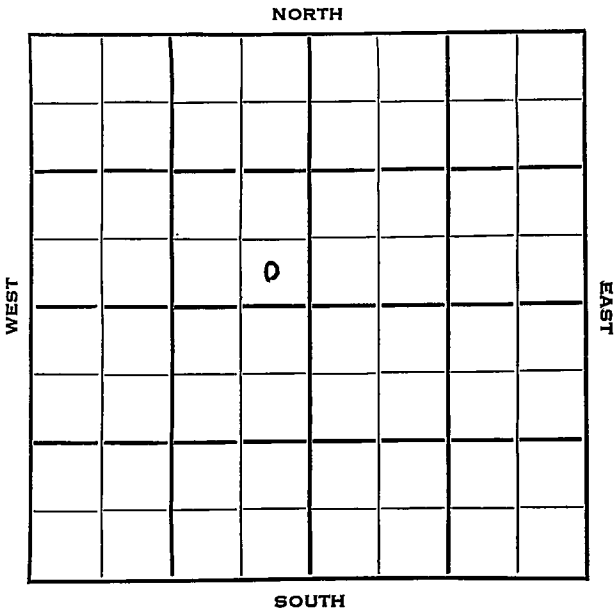

Morton


KANSAS ✓

Sec. 28 Twp. 34 R. 43 WWell No. # 1 Roll "A" FarmCities Service Oil CompanyNoble Drlg. ContractorGreenwood Gas Pool

NORTH

 Ft. from N. Line330 Ft. from S. Line330 Ft. from E. Line Ft. from W. Line

SE SE NW

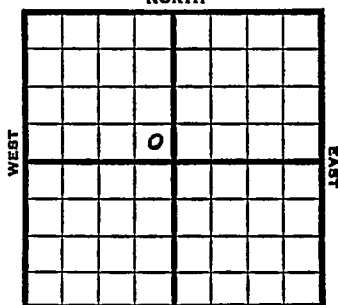

SOUTH

1953 Elev. 3502' REPORT

5/13 Location

5/21 13" @ 534'
Drlg 1140'

5/28 Drlg.

7/1 NR

7/22 DST 2818-78 50' Mins, 481,000 gas
in 5", 90' gcm 450#
RTD 3220
Schl.
5" @ 3219'8/12 Spud 5-14-53
Gas Well
TD 3090
13" @ 534'DST 1111-61, opn 3/4 hrs., rec. 100'
mud, 500' wtr., 225#DST 1250-96, opn 3/4 hrs., rec. 121'
gcm, 850#

Top 2705

DST 2743-90, opn 1 hr., gas in 5",
rec. 416,000 gas in 6", 210' gcm,
TD 3090,

5" @ 3089,

CO to 3054, 40/3032-40, 50/3018-28

OVER

(Information Brought Forward)

1953
8/12

2000A

Top 2718, Lans 2944

1000A, 2,130,000 gas, CO to 3002

90/2948-66, 2000A, 2,600,000 gas,

30/2846-52, 50/2828-38, 35/2816-23,

6,400,000 gas, 2500A

24,2000,000 gas, PB 2800

30/2784-90, 25/2771-76, 25/2762-67

45/2739-48, 70/2712-26

295,000 gas 4000A 6000A

CO to 2871, 6700A

Comp. 31,400,000 gas, 434#

COMPLETED

3502	3562
2718	2944
7184	7558

J. G. McGEHEE


339

MAY 15 1958

Scout Cards	mm
Land Small Map	
Land Wall Map	33
Tracings	
France Map	
Pierce Map	
Misc	

Orig. Data

County Morton State Kansas
 Sec. 28 (Blk.) 34 (Sur.) 43W Map No.
 Operator Cities Service
 Well No. 1 Farm Roll "A"
 Elev. 3502 Location SE SE NW

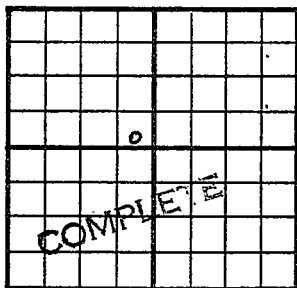

330 Ft. From S Line NW
330 Ft. From E Line Quarter

1st. Report

Completion AUG 12 1953

Remarks Greenwood Gas Pool

Noble Drlg. - Contr.

Spudding Date 5-14-53

Drlg. Data Gas well TD 3090

13" @ 534 DST 1111-61 open 3/4 hr.

Rec. 100' mud 500' wtr. 225#

DST 1250-96 open 3/4 hr. Rec. 121' gcm

850# Top. 2705 DST 2743-90 open 1 hr.

Gas in 5 min. Rec. 416,000 gas in 6 min.

210' gcm TD 3090 5" @ 3089 CO to 3054

40/ 3032-40 50/ 3018-28 2000 A

Top. 2718 Lans. 2944 1000 A

2,130,000 gas CO to 3002 90/ 2948-66

2000 A 2,600,000 gas 30/ 2846-52

50/ 2828-38 35/ 2816-23 6,400,000 gas

2500 A 24,200,000 gas PB 2800

30/ 2784-90 25/ 2771-76 25/ 2762-67

45/ 2739-48 70/ 2712-26 295,000 gas

J. G. McGEHEE

AUG 19 1953

Scout Cards	AD
Land Small Map	
Land Wall Map	33
Tracings	
France Map	
Pierce Map	
Misc.	

4000 A 6000 A - GO to 2871 6700 A
Comp. 31,400,000 Gas 434#

Orig. Data