


Well No.

Well No. 1-1-1 Chrhardt Farm

Well No. 1- J. Ehrhardt Farm
Argus Gas Company

NORTH

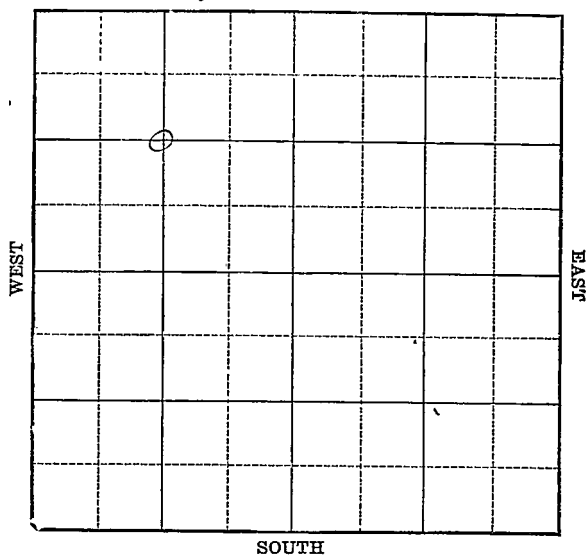

Drilling Remarks

Drilling Remarks

Total Depth.....

Abandoned.....

Form 202A-5M-11-25-38055

Map No. KANSAS Sec. 28 Twp. 34 R. 39th

Well No. 1- H. Chr. Lapat Farm

Argus Gas Company

NORTH


1320 Ft. from N. Line

-----Ft. from S. Line

Ft. from E. Line

1320 Ft. from W. Line

1930

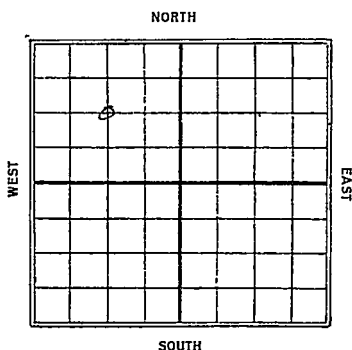

Date /

REPORT

DATE	7/9/80
------	--------

7/16	—
------	---

7/23 —

7/30	Right up
8/1	

8/6	<u>10</u>
8/13	10

8/13	avg.	1100
8/20	"	2390

8/27	8" 2549'
------	----------

9/3	Crust	2549
9/10	Spore	2549-27

1110	2000	25.11	2750
			TD: 2750

Comp. S M gas

Morton
 Map No. **KANSAS** Sec. *25* Twp. *34* R. *39W*

Well No. *1 H. Eberhardt*

Regus Gas Company

Contractor


SECTION PLAT

1820 Ft. from N. Line

..... Ft. from S. Line

..... Ft. from E. Line

1820 Ft. from W. Line

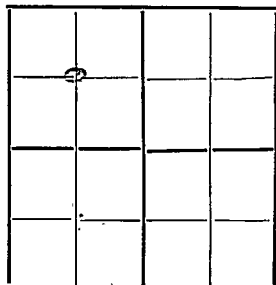

FIRST REPORTS

Location *✓*

Rig up

Drilling and Remarks:

RECORD

Cased *2* in., ft.

Sand *✓*

Gas

Oil

Total Depth

PRODUCTION

1st 24 hrs. Nat.

1st 24 hrs. after shot

Gas Cu. Ft.

Dry Hole

Abandoned

Date

JUL 9 193*2*

S. J. LEWIS Scout

*no direct map
to me*

Returned	
Cards	<i>[Signature]</i>
Tracing	<i>X</i>
France Map	<i>X</i>
Scarborough Map	<i>X</i>
Moody Map	<i>X</i>
Scarborough Plat Book	
Moody Plat Book	

Map No. KANSAS Sec. 28 Twp. 34 R. 39 WWell No. 1 N. E. E. 1/4 Sec 28Argue Gas Company


Contractor

SECTION PLAT

1320 Ft. from N. Line

Ft. from S. Line

Ft. from E. Line

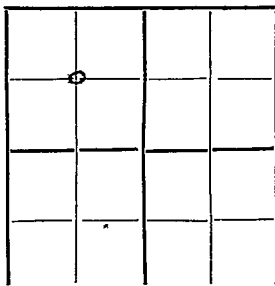1320 Ft. from W. Line

COMPLETED

Location

Rig up

Drilling and Remarks:

8 M Gas

RECORD

Cased _____ in., _____ ft.

Sand 2549 - 2750Gas 8 M

Oil _____

Total Depth 2750

PRODUCTION

1st 24 hrs. Nat. _____

1st 24 hrs. after shot _____

Gas _____ Cu. Ft.

Dry Hole _____

Abandoned _____


Date

SEP 10 1930

192

S. J. LEWIS Scout

no small m...
no wall m...

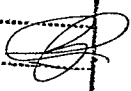Returned.....	
Cards.....	
Tracing.....	X
France Map.....	X
Scarborough Map.....	X
Moody Map.....	X
Scarborough Flat Book.....	
Moody Flat Book.....	