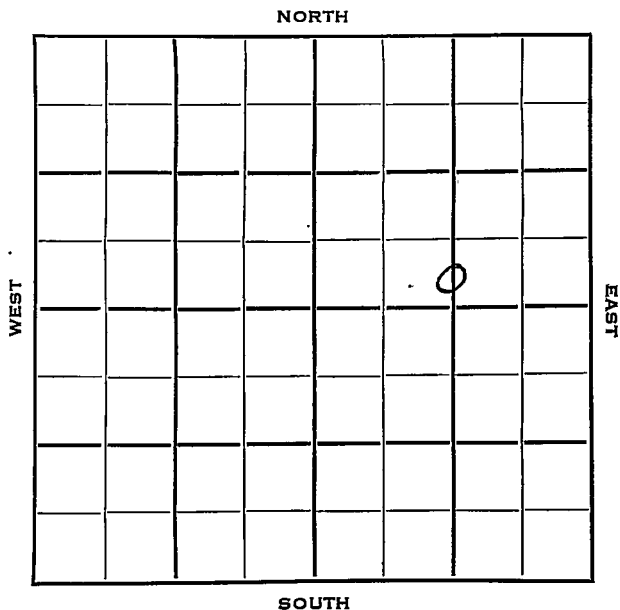


Section 28 Township 34 Range 40WWell No. #1-28 BohnCompany Panhandle Eastern

Morton KANSAS ✓

Sec. 28 Twp. 34 R. 40W

Well No. #1-28 Bohn Farm

Panhandle Eastern Company

Contractor


Hugoton Pool

2457 Ft. from N. Line

_____ Ft. from S. Line

1390 Ft. from E. Line

_____ Ft. from W. Line

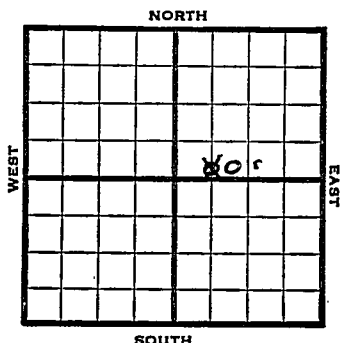

C S $\frac{1}{2}$ S $\frac{1}{2}$ NE

1953 Elev. 3376' REPORT

5/6 Spud 5-4-53

5/21 10" @ 460'
RTD 2501
6" @ 2489'
DD 2695

5/28 NR

6/3 Ho1 2434 Her 2473 Kr 2510
Win 2578 Up Ft. 2644 Low Ft 2653

6/10 NR
7/1 NR

8/26 "

9/2 Spud 5-4-53

Gas Well

TD 2695'

10" @ 460'

TD 2695'

TD 2501'

6" @ 2489'

DD 2695 Ho. 2434, Her 2473, Kri 2510,
Win 2578, Ft. Riley 2644, 15000 A
8000 A

Comp. 22,401,000 gas 397#

COMPLETED

County Morton State Kansas

Sec. 22 (Blk. 2A) (Sur. 40W) Map No. _____

Operator Panhandle Eastern

Well No. 7-28 Farm Bohn


2457 Ft. From N Line Sec.

7390 Ft. From 7 Line Quarter

1st. Report MAY 6 1953

Completion

Remarks

Spudding Date 5-4-53

Drig. Data Hugoton Pool

J. G. McGEHEE

J. G. McGEHEE