


Map No. 29 Twp. 34 R. 1W
 Well No. 1 Lytle Farm
McCullough Company

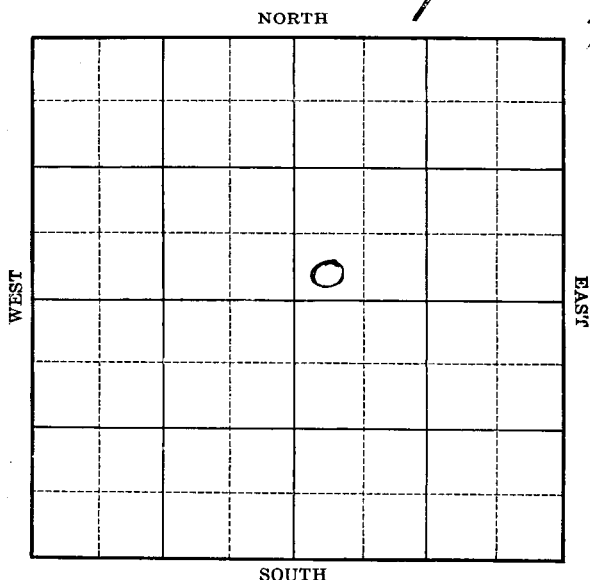

Location _____

Drilling Remarks _____

Rig Up _____

Drilling Remarks _____

RECORD

Cased _____ in. _____ ft.

Sand _____

Gas _____

Oil _____

Total Depth _____

PRODUCTION

1st 24 hrs. Nat. _____

1st 24 hrs. after shot _____

Gas _____ cu. ft.

Dry Hole _____

Abandoned _____

KANSAS

Map No. _____ Sec. 29 Twp. 34 R. 1wWell No. 1 - Little Farm _____Mc Cullough Oil Company

NORTH


_____ Ft. from N. Line

330 Ft. from S. Line

_____ Ft. from E. Line

330 Ft. from W. Line

WEST

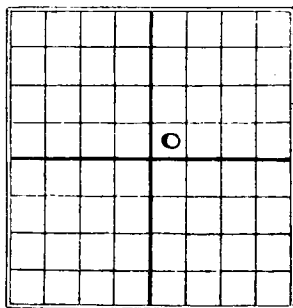

EAST

SOUTH

1928

Date

REPORT

<u>6/13</u>	<u>Loc.</u>
<u>6/20</u>	<u>—</u>
<u>6/27</u>	<u>—</u>
<u>7/3</u>	<u>—</u>
<u>7/11</u>	<u>—</u>
<u>7/18</u>	<u>—</u>
<u>7/25</u>	<u>—</u>
<u>8/1</u>	<u>—</u>
<u>8/7</u>	<u>—</u>
<u>8/15</u>	<u>—</u>
<u>8/22</u>	<u>R.O.G.</u>
<u>9/5</u>	<u>Spud + S.D.</u>
<u>9/12</u>	<u>—</u>
<u>9/19</u>	<u>—</u>
<u>9/26</u>	<u>—</u>
<u>10/3</u>	<u>Rign up</u>
<u>10/10</u>	<u>Spud</u>
<u>10/17</u>	<u>Only 1350'</u>
<u>10/17</u>	<u>" 2400'</u>
<u>10/31</u>	<u>" 3150'</u>
<u>11/7</u>	<u>" 3560'</u>
<u>11/14</u>	<u>" 4100'</u>

11/21- Top line 4015'
T.D. 4160-Standardizing

11/28

12/5

12/12- Drg 4200'

12/19- drg out cem 4200

12/26- " 4310'

1929

1/2 " 4350'

1/9- " 4482' T.L. 4128

1/16- Base line 4532'

Wilcox 4634-40' HFW

1/23- S.D.O. - 4638' TD-SLM

1/30- Wilcox 4634-38'

T.D. 4638' - HFW

Dry & Abandoned

Summer
Homestead
 MAP NO. KANSAS SEC. 29 TWP. 34 R. 1W

WELL NO. 1 Tattle

McCullough Oil COMPANY

CONTRACTOR

SECTION PLAT

		0	

_____ FT. FROM N. LINE

330 FT. FROM S. LINE

_____ FT. FROM E. LINE

330 FT. FROM W. LINE

ABANDONED

LOCATION _____

RIG UP _____

DRILLING AND REMARKS:

Wilcox 4634-38

NFW

DYA

RECORD

CASED _____ IN., _____ FT.

SAND _____

GAS _____

OIL _____

TOTAL DEPTH 4638

PRODUCTION

1ST 24 HRS. NAT. _____

1ST 24 HRS. AFTER SHOT _____

GAS _____ CU. FT.

DRY HOLE _____

ABANDONED _____

DATE

JAN 30 1929₁₉₂

S. J. LEVITS SCOUT

Map No. **KANSAS** Sec. 29 Twp. 34 R. 14Well No. 1 TuttleMc Cullough Oil Company

Contractor

SECTION PLAT

		0	

Ft. from N. Line

330 Ft. from S. Line

Ft. from E. Line

330 Ft. from W. Line

FIRST REPORTS

Location ✓

Rig up

Drilling and Remarks:

RECORD

Cased _____ in., _____ ft.

Sand _____

Gas _____

Oil _____

Total Depth _____

PRODUCTION

1st 24 hrs. Nat. _____

1st 24 hrs. after shot _____

Gas _____ Cu. Ft.

Dry Hole _____

Abandoned _____

Date

JUN 13 1928S. J. LEWIS Scout