


Section 29 Township 34 Range 33-WF

Well No. #1 Tucker "A"

Company Cities Service

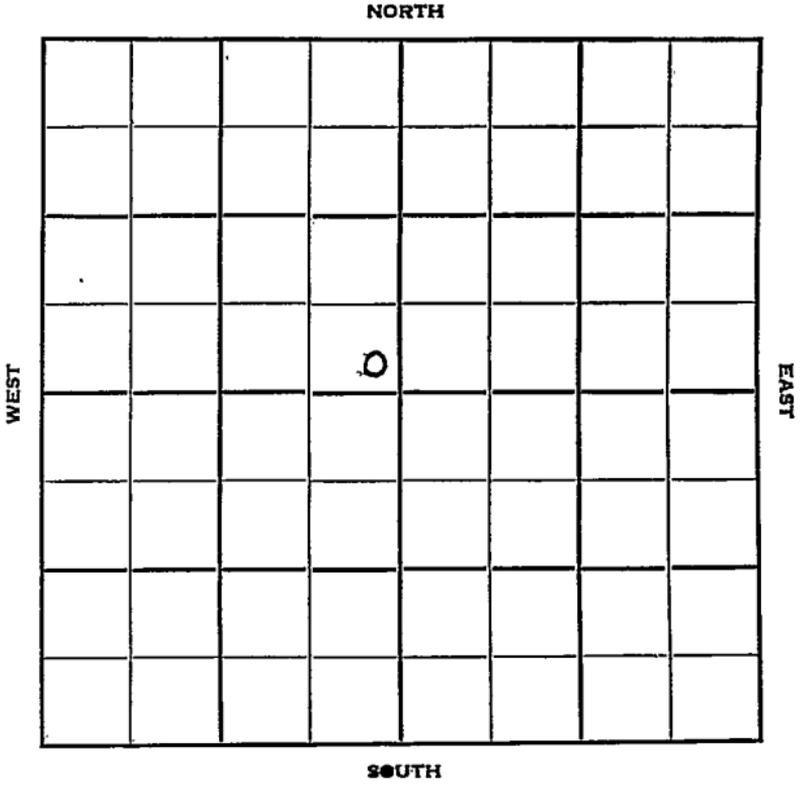

Sec. 29 Twp. 34 R. 33W

Well No. #1 Tucker "A" Farm

Cities Service Company

Barbour - Contr. Contractor

Hugoton Pool


 Ft. from N. Line

100' Ft. from S. Line

100' Ft. from E. Line

 Ft. from W. Line

SE NW

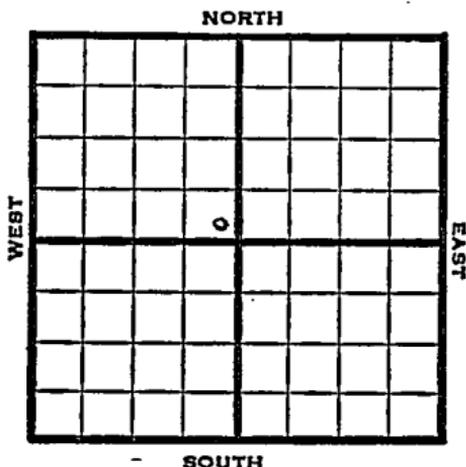

1950.	Elev 2873' REPORT
11/15	Spd 11-10-50 8" @ 680' Drlg. 1920'
1951 1/23	Spud 11-10-50 8" @ 680 Her 2607 Krider 2641 Win 2726 TD 2770 5 1/2" @ 2769 40/2724-42 30/3708-14 150/2672-2702 40/2642-50 40/2616-24 15000 A Comp 15,900,000 gas 426# Completed COMPLETED

County Seward State Kansas

Sec. 29 (Blk.) 34 (Sur.) 33W Map No.

Operator Cities Service

Well No. 1 Farm Tucker "A"

Elev. 2873 Location SE NW

100 Ft. From S Line NW
100 Ft. From E Line Quarter

Ist. Report

Completion JAN 24 1951

Remarks Hugoton Pool

Barbour - Contr.

Spudding Date 11-10-50

Drilg. Data Gas well TD 2770

8" @ 680 Her. 2607 Krider 2641

Win. 2726 TD 2770 5 1/2" @ 2769

40/ 2724-42 30/ 2708-14 150/ 2672-2702

40/ 2642-50 40/ 2616-24 15000 A

Comp. 15,900,000 gas 426#

J. E. TYRA