


Section 29 Township 34 Range 34W

Well No. #1 Gammell

Company Plains Natural Gas

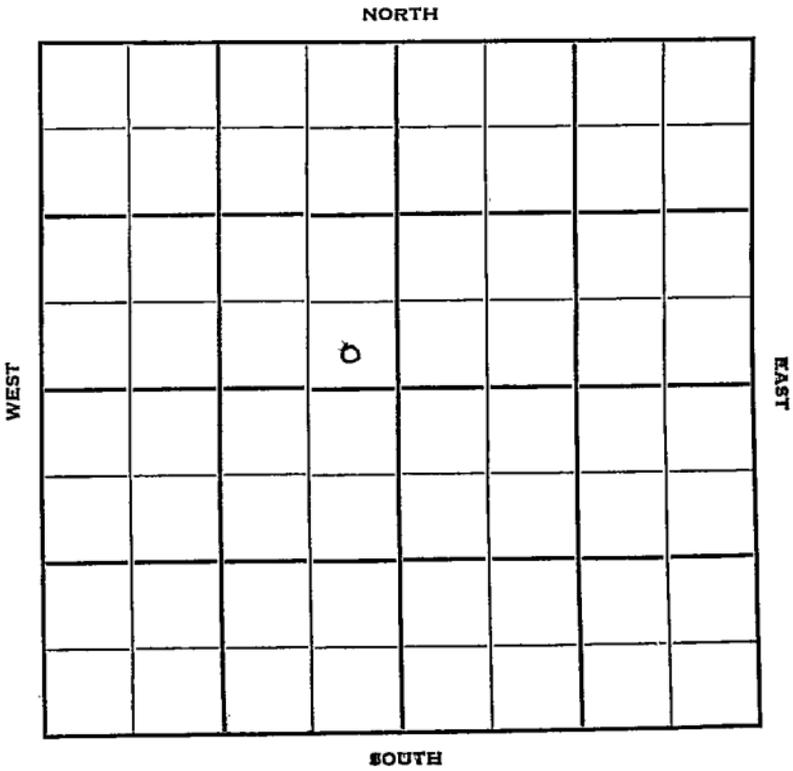

Sec. 29 Twp. 34 R. 34W

Well No. #1 Gammell Farm

Plains Natural Gas Company

Hugoton Pool Contractor


 Ft. from N. Line

200' Ft. from S. Line

200' Ft. from E. Line

 Ft. from W. Line

SE NW

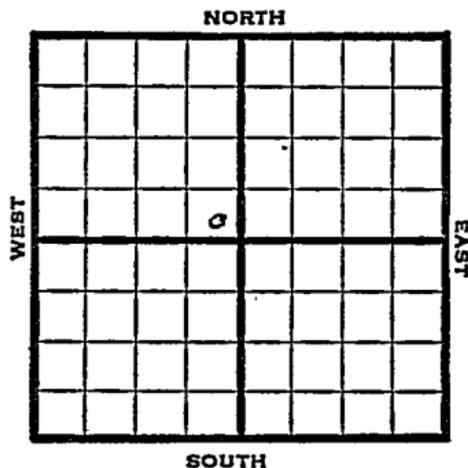

1950

Elev 2942

REPORT

9/27 Location
10/18 Spud 9-26-50
10" @ 724
7" @ 2762
TD 2765
Hol 2577 Her 2636
Krider 2669 Win 2752
300/2695-2745, 48/2670-78
90/2643-58, 18/2637-40, 42/2752-59
16000 total acid
Comp 9, 418,000 gas 411#
Completed

COMPLETED

County Seward State Kansas

Sec. 29 (Blk. Twp.) 34 (Sur. Rge.) 3 4W Map No.

Operator Plains Natural Gas

Well No. 1 Farm Gammell

Elev. 2942 Location SE NW

200 Ft. From S Line NW

200 Ft. From E Line Quarter

Ist. Report SEP 27 1950

Completion _____

Remarks _____

Spudding Date _____

Drlg. Data Hugoton Pool

Location

J. E. TYRA

County Seward State Kansas

Sec. 29 (Blk. 34) (Sur. 34W) Map No.

Operator Plains Natural Gas

Well No. 1 Farm Gammell

Elev. 2942 Location SE NW

		0			
		COMPLETE			

200 Ft. From S Line NW

200 Ft. From E Line Quarter

Ist. Report

Completion OCT 18 1950

Remarks Hugoton Pool

Spudding Date 9-26-50

Drilg. Data Gas well TD 2765

10" @ 724 7" @ 2762 TD 2765

Hol. 2577 Her. 2636 Krider 2669

Win. 2752 300/ 2695-2745 48/ 2670-78

90/ 2643-58 18/ 2637-40 42/ 2752-59

16000 total acid Comp. 9,418,000 gas
414#