


Morton

KANSAS

SECTION 29 TOWNSHIP 34 RANGE 43W

WELL NO. #5 Roll

COMPANY Musgrove

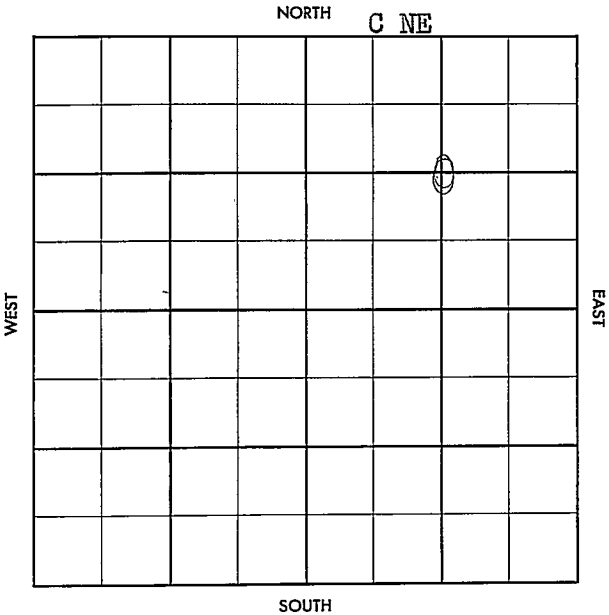

County Morton Elev. _____
Sec. 29 Twp. 34 Rge. 43W
Company Musgrove
Farm Name Roll No. 5

TOPS	DEPTH	LOG	DATUM	Loc. in Sec.
Anh.				C NE
TP.				
H.				
Tr.				
Dg.				
Bl.				
L.				Geol.
K.C.				Contr.
B.K.C.				Co. Tools
Ce.				Pool
C.				Interstate
M.				
M.				
K.				
Mz.				
Me.				
V.				
S.				
S.				
A.				
R.				
Pe.				
G.				
T.D.				

FIRST REPORT	
FEB 20 57	

Date Comm. 2-15-57 Panhandle Eastern (FO)
8" @ 1174/650 W O C

34

County Morton Elev. 3480
 Sec. 29 Twp. 34 Rgs. 43W
 Company Musgrove
 Farm Name Roll No. 5

TOPS	DEPTH	LOG	DATUM	Loc. in Sec.
Anb. <u>✓</u>				C NE
Tr. <u>✓</u>				
Dg. <u>✓</u>				
Bl. <u>✓</u>				
L. <u>✓</u>				Geol. <u> </u>
K.C. <u>✓</u>				Contr. <u> </u>
B.K.C. <u>✓</u>				Co. Tools <u> </u>
Ce. <u>✓</u>				Pool <u> </u>
C. <u>✓</u>				Interstate <u> </u>
M. <u>W</u>		<u>4082</u>		
M. <u>Purdy</u>		<u>4136</u>		
K. <u>13 Pdy</u>		<u>4187</u>		
Mz. <u> </u>				
Ma. <u> </u>				
V. <u> </u>				
S. <u> </u>				
S. <u> </u>				
A. <u> </u>				
R. <u> </u>				
Pe. <u> </u>				
G. <u> </u>				
TD. <u>4220</u>				

COMPLETE

Date Comm. 2-15-57 Panhandle Eastern (FO)8" @ 1174/650 W O.C. W 27. 10 3870MAR 5 57 5 1/2 @ 4220 / 500 MAR 13 57CO 4198 48/4148-56\$ 15 BO/H WOT MAR 20 57 57P & F/wg 580 Bopd no. in