


DX 78-1

Morton KANSAS

Section 29 Township 34 Range 43 W

Well No. # 1 Switzer

Company Musgrove Petroleum

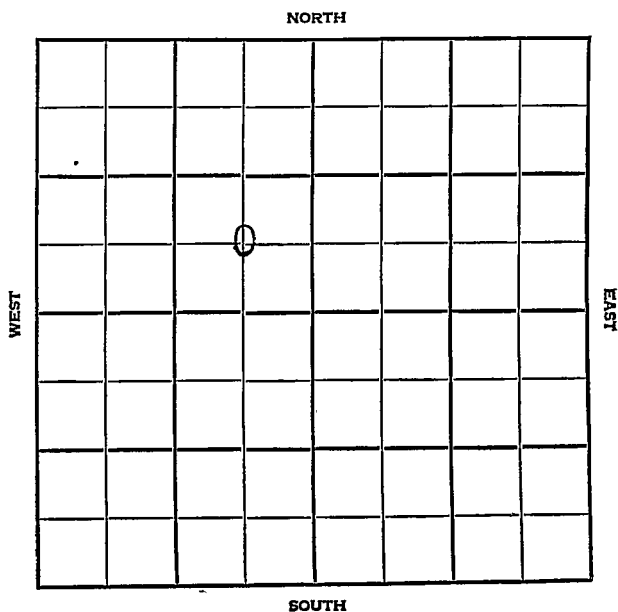

Morton KANSAS

SEC.	TWP.	R.
29	34	13W

WELL NO.

1 Switzer

FARM

COMPANY

Musgrove Petr.

CONTRACTOR

Co. Tools

Interstate Pool

Ft. from N. Line

660

Ft. from S. Line


660

Ft. from E. Line

Ft. from W. Line

C SE NW

PEPL FO

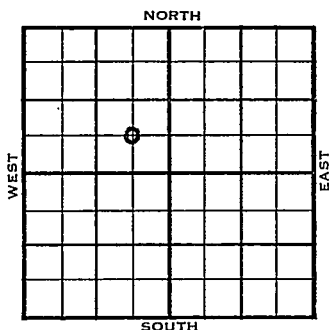

1955

ELEVATION

3484'

REPORT

2/2

Spud 1-29-55

8" @ 1208'

Drlg. 2500'

3/16

Spud 1-29-55, oil well, TD 4276

8" @ 1208, DST 2672-2772,

open 1 hr gas in 42 min. 116,

000 CFG 195' GCM, 450#,

Morrow 4057, Purdy sd 4167,

TD 4275, DST 4238, -75, open

1 1/2 hr. Rec 284' MW, 5" @

4275 36/4267-76, Top 2694

Lans 2923

Comp 195 BOPD

COMPLETED

County Morton State Kansas
 Sec. 29 (Blk. 34) (Sur. 43W) (Twp. 34) (Rge. 43W) Map No.
 Operator Musgrove Petroleum
 Well No. 1 Farm Switzer
 Elev. Location C SE NW




660 Ft. From S Line NW
660 Ft. From E Line Quarter
 Ist. Report FEB 2 1955
 Completion
 Remarks PEPL farmout
Co. tools
 Spudding Date 1-29-55

Drlg. Data Interstate Pool
8" @ 1208 drlg. 2500

FABEN GILSTRAP

County Morton State Kansas
 Sec. 29 (Blk.) 34 (Sur.) 43W Map No.
 Operator Musgrove Pet.
 Well No. 1 Farm Switzer
 Elev. 3484 Location C SE NW

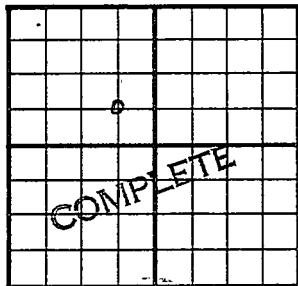

660Ft. From S Line NW
660Ft. From E Line Quarter
 Ist. Report
 Completion MAR 16 1955
 Remarks Interstate Pool
Co. tools
 Spudding Date 1-29-55

Drlg. Data Oil well TD 4276
8" @ 1208 DST 2672-2772 open 1 hr.
gas in 42 min. 116,000 cfg 195' gcm
450# Morrow 4057 Purdy sd. 4167
TD 4275 DST 4238-75 open 1 1/2 hr.
Rec. 284' mw 5" @ 4275 36/ 4267-76
Top. 2694 Lans. 2923
Comp. 195 bopd

FABEN GILSTRAP