

DX 78-1

Morton

KANSAS

29


34

43W

Section _____ Township _____ Range _____

Well No. #3 Roll

Company Musgrove

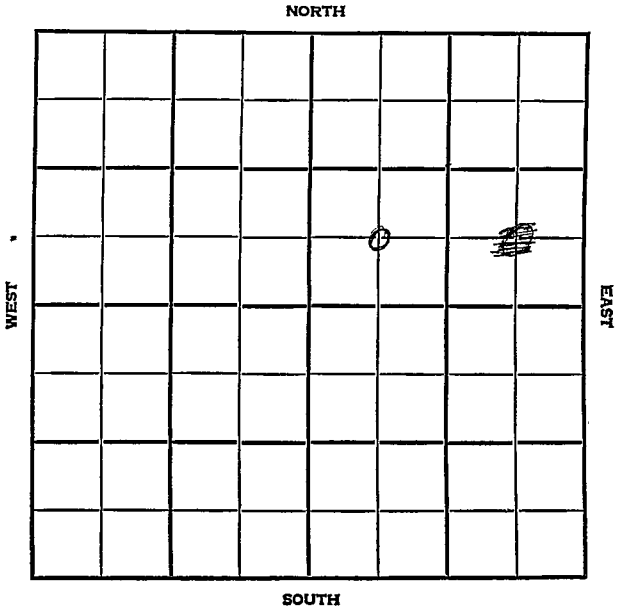

County Morton

Elev. _____

Sec. 29Twp. 34Rge. 13WCompany MusgroveFarm Name BollNo. 3

TOPS

DEPTH

LOG

DATUM

Loc. in Sec. _____

Anh. _____

Tp. _____

H. _____

Tr. _____

Dg. _____

BL. _____

L. _____

K.C. _____

B.K.C. _____

Ce. _____

C. _____

M. _____

M. _____

K. _____

Mz. _____

Mq. _____

V. _____

S. _____

S. _____

A. _____

R. _____

PE. _____

G. _____

T.D. _____

C SW NE

Geol. _____

Contr. _____

Pool _____

Interstate _____

FIRST REPORT	
	0
OCT 31 '56	

Date Comm. _____

PEPL - FO

811 @ 1170/650

WOC

R. G.

34

County Morton Elev. 3494
 Sec. 29 Twp. 34 Rge. 13W
 Company Musgrove
 FarmName Roll No. 3

TOPS	DEPTH	LOG	DATUM	Loc. in Sec.
Anh.				C SW NE
Tr.				
H.				
Tr.				
Dg.				
Bl.				
L.				Geol.
K.C.				Contr.
B.K.C.				
Ce.				Pool
C. <u>Mush</u>		<u>4187</u>		Interstate
M. <u>Purdy</u>		<u>4160</u>		
M. <u>Base Purdy</u>		<u>4207</u>		
K.				
Mz.				
Mo.				
V.				
S.				
S.				
A.				
R.				
PE.				
G.				
TD.	<u>4255</u>			COMPLETE

Date Comm. 10-27-56 PEPL - FO
8" @ 1170/650 WOC NOV 7 '56 10 3505
NOV 13 '56 5 1/2 4254/225 CO 4254
PF 4160-64 NOV 21 '56 Flw 25 Bop6
in 5 hrs no lw 1/2" ch. wo ST
fst * 28 56 DEC 5 '56 Ph.P. 634
Bopd no lw tr