

Morton


DX 78-1

KANSAS

Section 29 Township 34 Range 43^W

Well No. #4 Roll

Company Musgrove

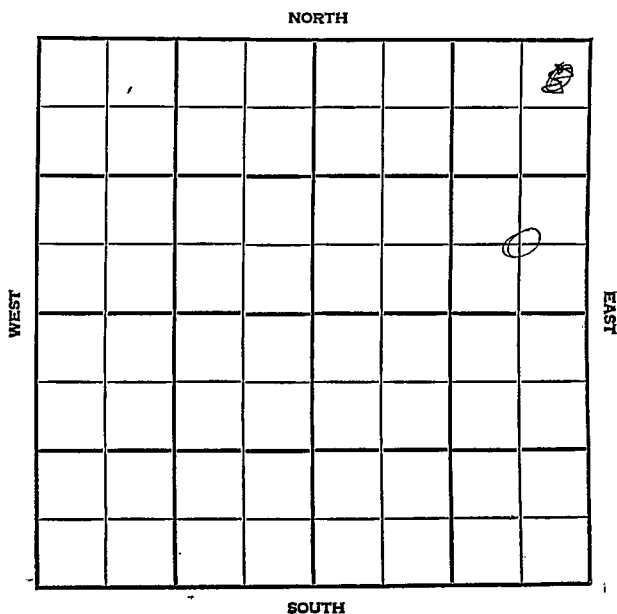

County Morton Elev. 3497
 Sec. 29 Twp. 34 Rge. 43W
 Company Masgrove
 Farm Name Roll No. 4

TOPS	DEPTH	LOG	DATUM	Loc. in Sec.
Anh.				C SE NE
TP.				
H.				
Tr.				
Dg.				
BL.				
L.				Geol.
K.C.				Contr.
B.K.C.				Interstate Co.
Ce.				Tools
C.				Interstate
M.				
M.				
K.				
Mz.				
Me.				
V.				
S.				
S.				
A.				
R.				
PE.				
G.				
T.D.				

Date Comm. expd. 11-9-56 P.E.P.L. (FO)
 8" @ 1193 w/650, Drlg. 1500

[Handwritten signature and notes]

County Morton Elev. 3497
 Sec. 29 Twp. 34 Rge. 43W
 Company Musgrove
 Farm Name Roll No. 4

TOPS /	DEPTH	LOG	DATUM	Loc. in Sec.
Anb.				C SE NE
Tr.				
H.				
Tr.				
Dg.				
Bl. <u>Mw</u>		4107		
L. <u>Purdy</u>		4160		
K.C.				Geol.
B.K.C. <u>Mw</u>		<u>4108</u>		Contr.
Ce. <u>Purdy</u>		<u>4166-4209</u>		Interstate Co.
C.				ools
M.				Pool
M.				Interstate
K.				
Mz.				
Mo.				
V.				
S.				
S.				
A.				
R.				
Pe.				
G.				
T.D. <u>4297</u>	<u>4257</u>			

Date Comm. spd. 11-9-56 P.E.P.L. (FO)

8" @ 1193 w/650, Drlg. 1500 NOV 21 '56

ID 4010 NOV 28 '56 5 1/2 ~~4297~~ 225

DEC 5 '56 5 1/2 @ 4294 / 225 CO

4207 16 / 4166 - 70 Flw 20 Boph.

5 hrs 1/2" ch. DEC 12 '56 ✓ DEC 19 '56

st Flw 689 Bopd no water

graw 39° DEC 26 '56 no MISS.

complete