


DX 78-1

Morton KANSAS

Section 29 Township 34 Range 43W
Well No. 4 U. S. A. "D"
Company J. M. Huber

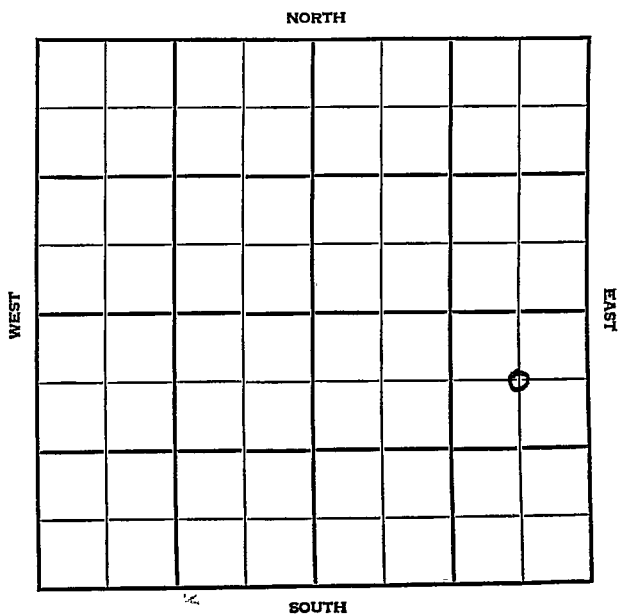

Morton KANSAS

SEC.	TWP.	R.
29	34	43W

WELL NO.

4 U. S. A. "D"

FARM

COMPANY

J. M. Huber

CONTRACTOR

Co. Tools

Interstate Pool

660


Ft. from N. Line

Ft. from S. Line

660

Ft. from E. Line

Ft. from W. Line

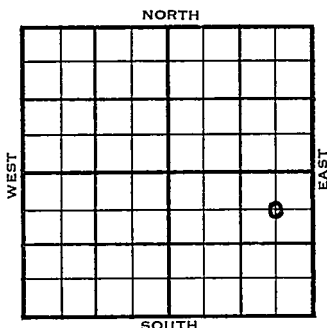

C NE SE

	ELEVATION	REPORT
1955	3523'	

1/19 Location


3/23

Spud 1-27-55, oil well, TD 4278
 8" @ 1200; Morrow sh 4085,
 Morrow sd. 4188, TD 4278,
 5" @ 4274 8/4226-28, 8/4218-20
 8/4210-12, 20/4205-10, 7 BFPH
 7% wtr 36/4196-4205
 S/7 BOPH
 Comp 130 BOPD 4½% wtr

COMPLETED



County Morton State Kansas
Sec. 29 (Blk. 34) (Sur. 43W) Map No. 43W
Operator J. M. Huber
Well No. 4 Farm U.S.A. "D"
Elev. Location C NE SE

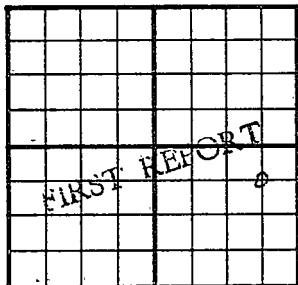

660 Ft. From N Line SE
660 Ft. From E Line Quarter
1st. Report JAN 1 9 1955
Completion
Remarks
Co. tools
Spudding Date

Drlg. Data Interstate Pool
Location

FABEN GILSTRAP

County Morton State Kansas
 Sec. 29 (Blk.) 34 (Sur.) 43W Map No.
 Operator J. M. Huber
 Well No. 4 Farm U.S.A. "D"
 Elev. 3523 Location C NE SE



660 Ft. From N Line SE
660 Ft. From E Line Quarter
 Ist. Report
 Completion MAR 23 1955
 Remarks Interstate Pool
Co. tools
 Spudding Date 1-27-55

Drilg. Data Oil well TD 4278
8" @ 1200 Morrow sh. 4085 Morrow sd.
4188 TD 4278 5" @ 4274 8/ 4226-28
8/ 4218-20 8/ 4210-12 20/ 4205-10
7 bfph 7% wtr. 36/ 4196-4205
S/ 7 boph Comp. 130 bopd 4 $\frac{1}{2}$ % wtr.

FABEN GILSTRAP