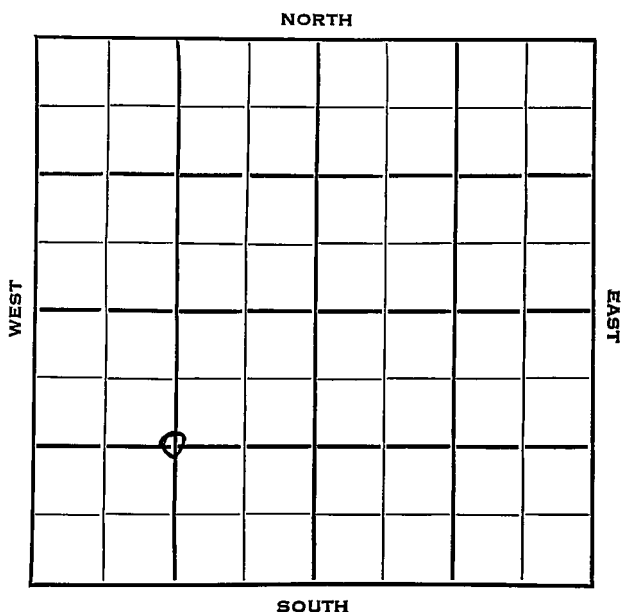


Section 29 Township 34 Range 43WWell No. 1 U. S. A. Gas Unit "C"Company Stanolind HUBER

Morton		KANSAS
SEC.	TWP.	R.
29	34	43 W
WELL NO.		
# 1 U.S.A. Gas Unit "C"		FARM
COMPANY		
HUBER		
Stanolind		
CONTRACTOR		

Greenwood Pool


_____ Ft. from N. Line

1320 _____ Ft. from S. Line

_____ Ft. from E. Line

1320 _____ Ft. from W. Line

G SW/4

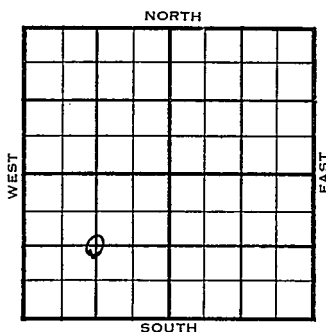

	ELEVATION	REPORT
1954	3523'	
3/3	Location	Miss. Test
5/19	Spud 3-22-54	
	Oil Well	
	TD 4572'	
	8" @ 1237'	
	Top 2726'	
	DST 2797'-2810' opn 1 hr, rec 5' Mud	
	460# Lans 2957'	
	DST 2951'-74' opn 1 hr, rec 100' hgcm	
	460# Morrow 4077', Purdy 4192'	
	DST 4191'-4204' opn $\frac{3}{4}$ hr, rec 1047' oi	
	1200# Keys 4472'	
	DST 4472'-4500' opn $\frac{1}{2}$ hr, rec 15' Mud	
	200# Miss 4542'	
	DST 4500'-47' opn 1 hr, rec 280' o & gc	
	m, 325' sw, 930#	
	TD 4572'	
	5" @ 4560'	
	CO to 4493'	
	36/ 4210-16 F/ 133 bo $6\frac{1}{2}$ hr.	
	48/ 4192-4200 F/ 81 bo 10-3/4 hr.	
	S/ 47 bfph 25% Wtr. SP 4205	
	S/ 8 boph	
	Comp 252 bopd	
	COMPLETED	

County Morton State KansasSec. 29 (Blk.) 34 (Sur.) 43W Map No.Operator StanolindWell No. 1 Farm U.S.A. Gas Unit "C"Elev. Location C SW/4

1320 Ft. From S Line SW1320 Ft. From W Line Quarter1st. Report MAR 3 1954

Completion

Remarks Miss. test

Spudding Date

Drlg. Data Greenwood PoolLocation

J. G. McGEHEE

Kansas

Map No. _____ Sec. 29 Twp. 34 R. 43W

Well No. 1 U.S.A. Gas Unit "C"

Huber Company

CORRECTION

Contractor

C SW/4


SECTION PLAT

_____ Ft. from N. Line

1320 Ft. from S. Line

_____ Ft. from E. Line

1320 Ft. from W. Line

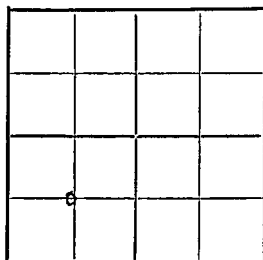

Morton County

Location _____

Rig up _____

Drilling and Remarks:

RECORD

Cased _____ in., _____ ft.

Sand _____

Gas _____

Oil _____

Total Depth _____

PRODUCTION

1st 24 hrs. Nat. _____

1st 24 hrs. after shot _____

Gas _____ Cu. Ft.

Dry Hole _____

Abandoned _____

Reported
Stanolind

Date

MAY


5

1954

J. G. MCGEHEE

Scout

County Morton State Kansas
 Sec. 29 (Blk. 34) (Sur. 43W) Map No. 43W
 Operator Huber Corp.
 Well No. 1 Farm U.S.A. Gas Unit "C"
 Elev. 3523 Location C SW/4

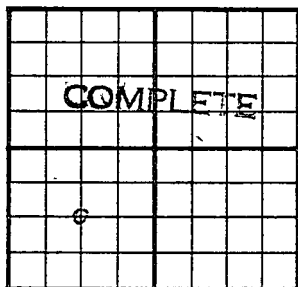

1320 Ft. From S Line SW

1320 Ft. From W Line Quarter

1st. Report

Completion MAY 1 9 1954Remarks Greenwood PoolSpudding Date 3-22-54Drilg. Data Oil well TD 45728" @ 1237 Top. 2726 DST 2797-2810open 1 hr. Rec. 5' mud 460#Lans. 2957 DST 2951-74 open 1 hr.Rec. 100' hgcm 460# Morrow 4077Purdy 4192 DST 4191-4204 open $\frac{1}{4}$ hr.Rec. 1047' oil 1200# Keys 4472DST 4472-4500 open $\frac{1}{2}$ hr. Rec. 15' mud200# Miss. 4542 DST 4500-47 open 1 hrRec. 280' o & gcm 325' sw 930#TD 4572 5" @ 4560 CO to 449336/ 4210-16 F/ 133 bo $6\frac{1}{2}$ hr.48/ 4192-4200 F/ 81 bo 10 $\frac{3}{4}$ hr.S/ 47 bfph 25% wtr. SP 4205S/ 8 boph Comp. 252 bopd

J. G. McGEHEE