

Section 29 Township 34 Range 13W


Well No. #2 USA "C"

Company Huber Corp

NORTH

WEST

EAST

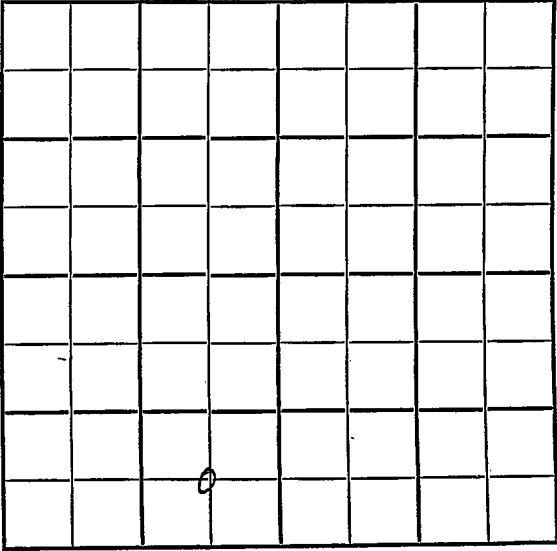

SOUTH

Morton		KANSAS
SEC.	TWP.	R.
29	34	43 W
WELL NO.		
# 2 USA "C"		FARM
COMPANY		
Huber Corp.		
CONTRACTOR		

S. Greenwood Pool


NORTH

Ft. from N. Line

660 Ft. from S. Line

660 Ft. from E. Line

Ft. from W. Line

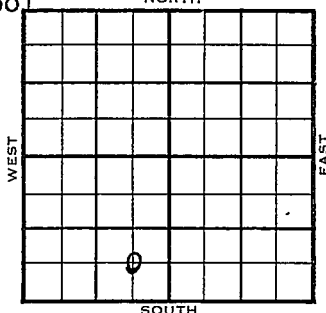


C SE SW

	ELEVATION	REPORT
1954	3518'	
8/18	Location	
9/22	Spud 8-17-54 - Oil Well	
	TD 4255'	
	8-5/8" @ 1216'	
	DST 4096-4130', opn 30", gas in 2",	
	4,070,000 cfg 1200#	
	TD 4255'	
	DST 4115-4219, opn 26", gas in 3 1/2",	
	2,058,000 cfg, 390' fluid, 270' clean	
	oil, 60' salty WCO, 60' SW, 1200#	
	5" @ 4252'	
	8/4207-09k 45 bswph	
	CO to 4208	
	8/4204-06, 20/4199-4204, 20/4193-98,	
	S&F/18 boph 7 hrs., 20/4188-93	
	F/18 boph	
	Schl ops: Top 2720', Lens 2950',	
	Morrow sh 4067', Morrow sd 4170'	
	TD 4250'	
	comp. 656 bopd	

COMPLETED

County Morton State Kansas
 Sec. 29 (Blk.) 34 (Sur.) 43W Map No.
 Operator Huber Corp.
 Well No. 2 Farm USA "C"
 Elev. 3518 Location C SE SW

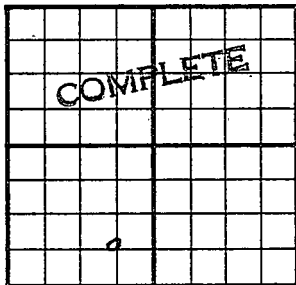

660 Ft. From S Line SW
660 Ft. From E Line Quarter
 1st. Report Aug 18 1954
 Completion SEP 22 1954
 Remarks
Co. Tools
 Spudding Date 8-17-54

Drlg. Data Oil well TD 4255. Greenwood Pool
8 5/8" @ 1216 DST 4096-4130 open 30 min.
 gas in 2 min. 4,070,000 cfg 1200#
 TD 4255 DST 4115-4219 open 26 min.
 gas in $3\frac{1}{2}$ min. 2,058,000 cfg 390' fluid.
 270' clean oil 60' salty wco 60' sw
 1200# 5" @ 4252 8/ 4207-09 45 bswph
 CO to 4208 8/ 4204-06 20/ 4199-4204
 20/ 4193-98 S & F/ 18 boph 7 hr.
 20/ 4188-93 F/ 18 boph
 SCHLUMBERGER TOPS
 Top. 2720 Lans. 2950 Morrow sh. 4067
 Morrow sd. 4170 TD 4250
 Comp. 656 bopd

FABEN GILSTRAP

County **Morton** State **Kansas**

Sec. **29** (Blk. **34** (Sur. **43W** Map No.

Operator • Huber Corp.

Well No. **2** Farm **USA "C"**

Elev.	Location	C SE SW

FIRST REPORT

660 Ft. From S Line SW

660 Ft. From E Line Quarter

1st. Report AUG 18 1954

Completion

Remarks:

Spudding Date .

Drig. Data S. Greenwood Pool

Location

FABEN GILSTRAP