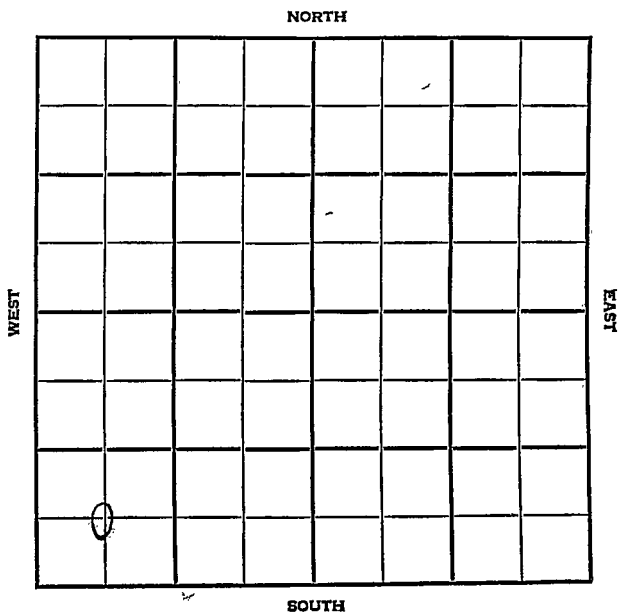


Morton KANSAS

Section 29 Township 34 Range 43 WWell No. # 5 U.S.A. "C"Company Huber Corp.

Morton KANSAS


SEC. 29	TWP. 34	R. 43W
WELL NO. 5 U. S. A. "C"		
FARM FARM		
COMPANY Huber Corp.		
CONTRACTOR		

_____ Ft. from N. Line

660 _____ Ft. from S. Line

_____ Ft. from E. Line

660 _____ Ft. from W. Line

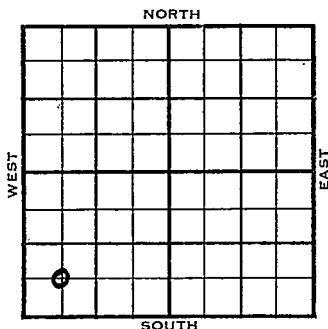

C SW SW

	ELEVATION	REPORT
1954	3519'	

11/10 Location


1955

1/19 Spud 12-15-54 Oil well TD 4254
 8-5/8" @ 1200 Top. 2716 Lans 2944
 Morrow sh. 4070 Morrow sd. 4183
 TD 4252 5" @ 4252 DD 4254 CO
 8/4214-16 F/8 BOPH 104/4188-4214
 F/60 BO 2 hr. F/810 BO 2 1/2 hr.
 1237# F/54.51 BO 3 hr.
 Comp.

COMPLETED

FABEN GILSTRAP

County Morton State Kansas
 Sec. 29 (Blk.) 34 (Sur.) 43W Map No.
 Operator Huber Corp.
 Well No. 5 Farm U.S.A. "C"
 Elev. 3519 Location C SW SW

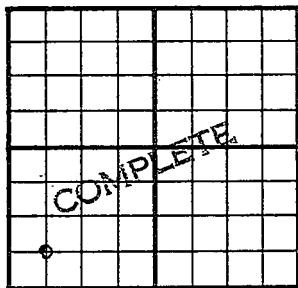

660 Ft. From S Line SW
660 Ft. From W Line Quarter
 1st. Report
 Completion JAN 1 9 1955
 Remarks
 Spudding Date 12-15-54

Drlg. Data Oil well TD 4254
8 5/8" @ 1200 Top. 2716 Lans. 2944
Morrow sh. 4070 Morrow sd. 4183
TD 4252 5" @ 4252 DD 4254 CO
8/ 4214-16 F/ 8 boph 104/ 4188-4214
F/ 60 bo 2 hr. F/ 810 bo 24 hr.
1237# F/ 54.51 bo 3 hr. Comp.

FABEN GILSTRAP