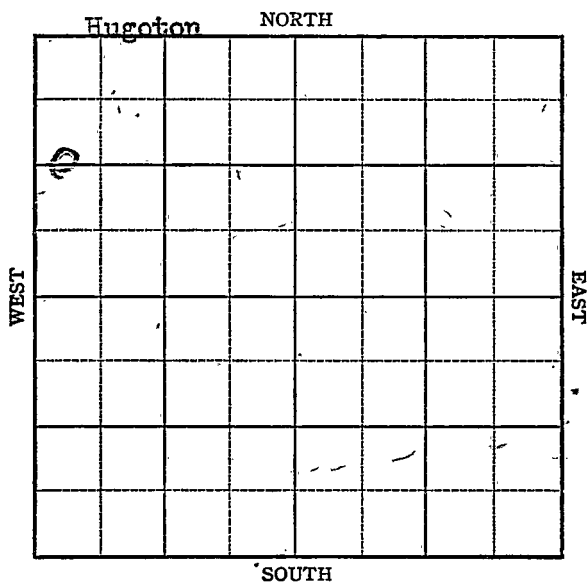


Section 29 Township 34 Range 38WWell No. 1 HoffmanCompany Panhandle Eastern

Stevens County ✓

Sec. 29 KANSAS 34 R. 38-W

Well No. 1 Hoffman Farm

Panhandle Eastern Company

Hugoton Pool

NORTH


1320 Ft. from N. Line

Ft. from S. Line

Ft. from E. Line

330 Ft. from W. Line

C W L NW

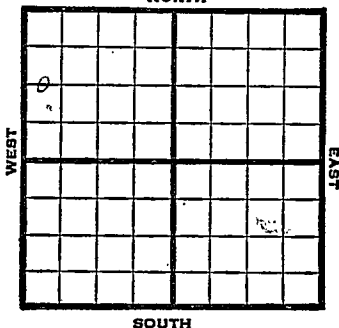

1947 Elev. 3318' REPORT

7/30 RUR

8/6 "

8/13 Drlg. 2479'

8/20 TD 2700'
7" @ 2691'

8/27 "

9/3 "

9/10 TD 2919'
250' of 5" Perf liner @ 2819'

9/17 7" @ 2691'
250' of 5" Perf Liner @ 2919'
5,488,000 Gas Nat.
396# Rock pressure
Total Depth 2919'

COMPLETED

Map No. _____ Sec. 29 Twp. 34 R. 38W

Well No. 1 Hoffman

Panhandle Eastern Company

FIRST REPORT

Contractor

C W L NW


SECTION PLAT

1320 Ft. from N. Line

_____ Ft. from S. Line

_____ Ft. from E. Line

330 Ft. from W. Line

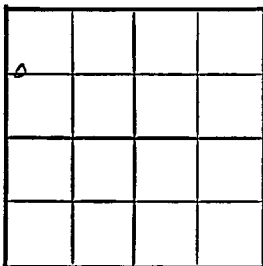

Stevens County

Location _____

Rig up _____

Drilling and Remarks:

R U R

RECORD

Cased _____ in., _____ ft.

Sand _____

Gas _____

Oil _____

Total Depth _____

PRODUCTION

1st 24 hrs. Nat. _____

1st 24 hrs. after shot _____

Gas _____ Cu. Ft.

Dry Hole _____

Abandoned _____

Date

JUL 30 1947

19

S. J. LEWIS

Scout

Map No. 0 Sec. 29 Twp. 34 R. 38W

Well No. 1 Hoffman

Panhandle Eastern Company

COMPLETE

Contractor

C W L NW


21.3818
SECTION PLAT

1320 Ft. from N. Line

_____ Ft. from S. Line

_____ Ft. from E. Line

330 Ft. from W. Line

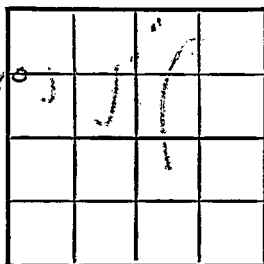

Stevens County

Location _____

Rig up _____

Drilling and Remarks:

7" @ 2691

200' x 5" Per line

@ 2918

5,488,000 Gas

296 R Pt

RECORD

Cased _____ in, _____ ft.

Sand _____

Gas _____

Oil _____

Total Depth 2918

PRODUCTION

1st 24 hrs. Nat. _____

1st 24 hrs. after shot _____

Gas _____ Cu. Ft.

Dry Hole _____

Abandoned _____

Date

SEP 17 1947 19

S. J. LEWIS Scout