


Section 29 Township 34 Range 40 WWell No. # 1 Parker "B"Company Cities Service

NORTH

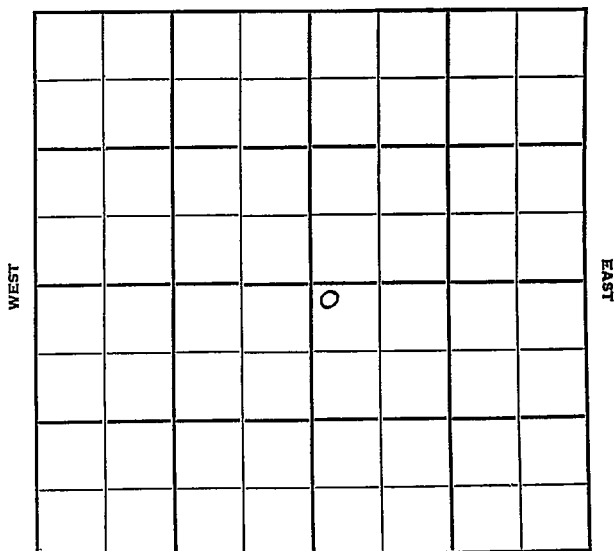

SOUTH

Morton

KANSAS

Sec. 29 Twp. 34 R. 40 W ✓

Well No. # 1 Parker "B" Farm

Cities Service

Company

Barbour Drlg.

Contractor

Hugoton Pool


225 Ft. from N. Line

Ft. from S. Line

Ft. from E. Line

225 Ft. from W. Line

NW SE

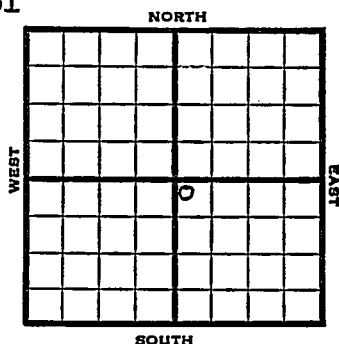

1951

Elev. 3384' REPORT

3/28

R U R

5/23

Spud 3-27-51
Gas Well TD 2670
8-5/8" 400 5 1/2" @ 2669
TD 2670 30/2572-78 3000 A
Krider 2466 Win 2538
Ft. Riley 2612 40/2562-70
60/2548-60 60/2534-46 70/2500-14
90/2482-90 30/2474-80 30/2466-72
22,500 A Comp. 12,100,000 gas 421#

COMPLETED



0

COMPLETE

22500 A Comp. 12,100,000 gas 421#

J. E. TYRA