


Section 3 Township 34 Range 21 W

Well No. # 4 J. C. Harper

Company United Prod.

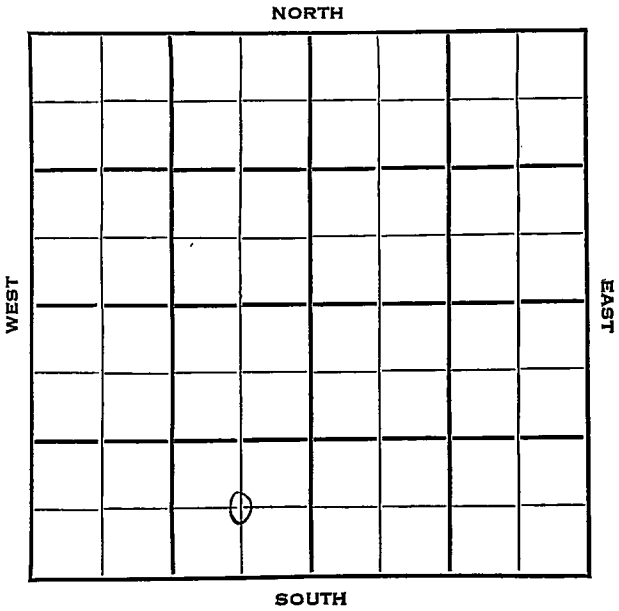

Clark

KANSAS

SEC.	TWP.	R.
3	34	21 W

WELL NO.

4 J. C. Harper

FARM

COMPANY

United Prod.

CONTRACTOR

H & P

Harper Ranch Pool


Ft. from N. Line

660 Ft. from S. Line

660 Ft. from E. Line

Ft. from W. Line

C SE SW

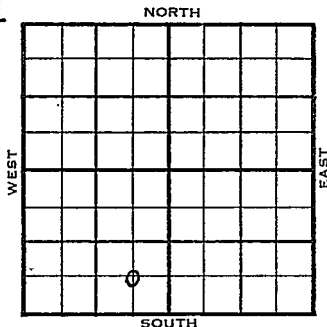

	ELEVATION	REPORT
1954	1846	<i>Plec. Pool</i>
4/14	RUR	
5/5	20" @ 74' w/250 sks	
	13" @ 504' w/300 sks	
	Drlg 4865'	
6/23	Spudding 4-15-54	
	Oil well	
	TD 5500	
	20" @ 94	
	13# @ 504	
	DST 5372-82 failed	
	DST 5376-83 open 3/4 hr. Rec. 10' gcm	
	1925#	
	DST 5423-35 open 1 3/4 hr. Rec. 1750'	
	vsgcsw 1945#	
	Miss. 5450	
	TD 5500	
	5" @ 5450	
	"M" sd. 5382-94 "O" sd. 5426-44	
	St. Gen. 5460	
	CO to 5416 40/ 5382-92 250 M-A	
	500 A 250,000 cfg frac 5000 A S/ load	
	4 mcfg spray oil F. 65 bo 2 1/2 mdfg	
	24 hr. F/ 54 bo 1, 813,000 gas 14 hr.	
	Comp. 49 bopd 1 1/2 mcfg	

COMPLETED

