


Clark KANSAS

DX 78-1

Section 3 Township 34 Range 21W
Well No. 6 J. C. Harper
Company United Prod.

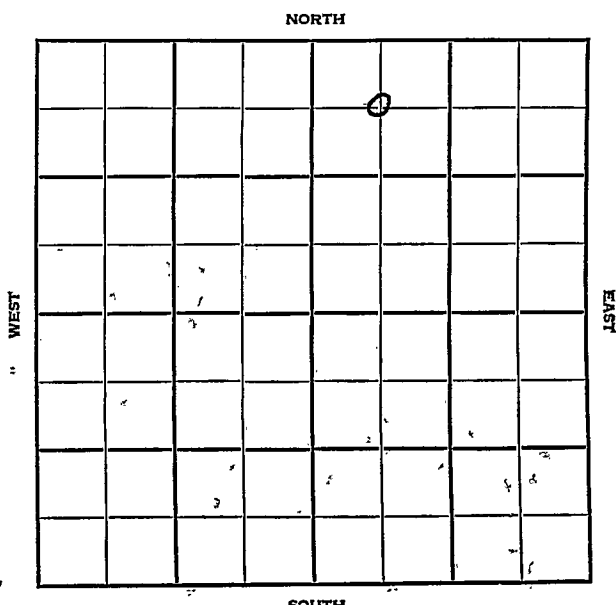


SEC.	TWP.	R.
3	34	21W
WELL NO.		
6 J. C. Harper		
COMPANY		FARM
United Prod.		
CONTRACTOR		
H & P		

660 Ft. from N. Line

Ft. from S. Line

Ft. from E. Line

660 Ft. from W. Line

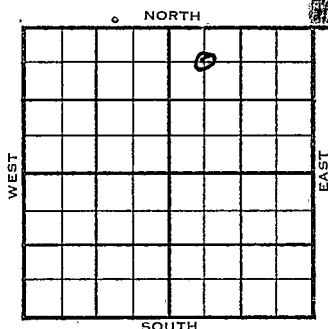

C NW NE MCPC has 35-33-21'.

	ELEVATION	REPORT
1954	1876	
6/15	Loc.	
6/25	20" @ 86 w/250 sax.	
	13" @ 500 w/500 sax.	
	8" @ 2337	
	Drlg. 2575'	(Ltr-McGehee)
7/1	DST 4189-4217 open 1 hr rec 180'	
	mud, 900' SW	
	DST 4553-4610 open 3/4 hr rec 570'	
	WCM, 3070' SW. 1765# 15 min.	
	Taking DS'	(Ltr-McGehee)
8/4	Spdg 6-12-54	
	Oil well	
	TD 5596	
	20" @ 86	
	13" @ 500	
	8" @ 2337	
	DST 4189-4217 open 1 hr. Rec. 180' mud	
	900' sw	
	DST 4553-4610 open 3/4 hr. Rec 570'	
	wcm 3070' sw 1765 #	
	DST 4640-4720 open 1 hr. Rec. 180'	
	swcm 180' mcs w 2640' sw 1830#	
	DST 5087-5120 open 1/2 hr. Rec. 5' mud	
	22#	
	DST 5380-90 open 1 1/2 hr. Rec. 5' mud	
	1720#	

Information brought forward

1954
8/4

DST 5390-5420 open 1 hr. gas in 18 min. 90,000 cfg 20 min. 98,000 gas 60 min. 500' ocm 90' free oil 1640#

DST 5420-60 open 1 hr. Rec. 100' mud 90' ho & gcm 305#

DST 5478-5592 open 65 min. gas in 5 min. 380,000 gas 15 min. 10,000 cfg 90 ocm oil 900' o & gcs w 1595#

TD 6696

5" @ 5566 CO to 5533 24/ 5487-93

S/40 bsw 4 bo 4 hr.

PB 5477 40/5442-52 st-frac F/67 bo 3 hr.

PB 5432 40/ 5406-16 3/4 mcfg frac 3000 A CO to 5477 F/ 281 bo 24 hr.

Elgin 4184 Heeb 4290 Lans. 4531

Marm. 5082 Morrow 5360

1st sd. 5380 2nd sd. 5404 Chester--

5472 F/ 254 bopd 122,000 cfg

Comp. 292 bopd

COMPLETED

County **Clark** State **Kansas**
 Sec. **3** (Blk.) **34** (Sur.) **21W** Map No.
 Operator **United Prod.**
 Well No. **6** Farm **J. C. Harper**
 Elev. Location **C NW NE**

FIRST REPORT

660 Ft. From **N** Line **NE**660 Ft. From **W** Line Quarter1st. Report **JUN 15 1954**

Completion

Remarks

H & P - Contr.

Spudding Date

Drig. Data

Location**J. G. MCGEE**

JUN 18 1954

Scout Cards _____

Land Small Map _____

Land Wall Map _____

Tracings _____


France Map _____

Pierce Map _____

Misc. _____

Orig. Data

County Clark State Kansas
 Sec. 3 (Blk. 34 (Sur. 21W Map No.)
 Operator United Prod.
 Well No. 6 Farm J. C. Harper
 Elev. 1876 Location C NW NE

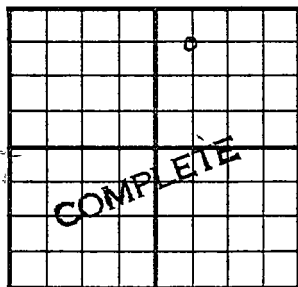

660 Ft. From N Line NE
660 Ft. From W Line Quarter

1st. Report

Completion AUG 4 1954

Remarks

H & P - Contr.

Spudding Date 6-12-54

Drlg. Data Oil well TD5596

20" @ 86 13" @ 500 8" @ 2337

DST 4189-4217 open 1 hr. Rec. 180' mud

900' sw DST 4553-4610 open 3/4 hr.

Rec. 570' wcm 3070' sw 1765#

DST 4640-4720 open 1 hr. Rec. 180'

swcm 180' mcs w 2640' sw 1830#

DST 5087-5120 open 1/2 hr. Rec. 5' mud

22# DST 5380-90 open 1 1/2 hr. Rec. 5' mud

1720# DST 5390-5420 open 1 hr. gas in

18 min. 90,000 cfg 26 min. 98,000 gas

60 min. 500' ocm 90' free oil 1640#

DST 5420-60 open 1 hr. Rec. 100' mud

90' ho & gcm 305# DST 5478-5592

open 65 min. gas in 5 min. 380,000 gas

J. G. McGEHEE

Orig. Data

15 min. 100,000 cfs 901 ocm 9701 611

900' o & psw 1505# -TD 5596 @ 5566

CO to 5533 24/ 5487-93 Ssgm 0014 SW 4 bo

4 hr. PB 5477 40/ 5442-52 Ssgm 0014 SW 4 bo

F/ 67 bo 3 hr. PB 5433 40/ 5406-16

3/4 mcf F/ 3000 A CO to 5477

F/ 281 bo 24 hr. E1gin 4184 Heeb. 4290

Lans. 4531 5082 Morrow 5360

1st sd. 5380 2nd sd. 5404 Chester 5472

F/ 254 bopd 122,000 cfs

Comp. 292 bopd