

Meade


KANSAS

SECTION # 3 TOWNSHIP 34 RANGE 30W

WELL NO. #1 W.H. Klein

COMPANY James Donoghue

NORTH

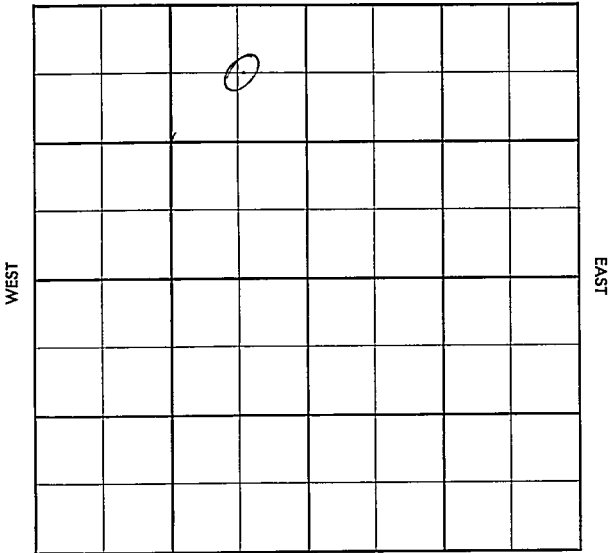

SOUTH

Meade

KANSAS

SEC. 3	TWP. 34	R. 30W
-----------	------------	-----------

WELL NO.

#1 W.H. Klein

FARM

COMPANY

James Donoghue

CONTRACTOR

Rocket Drlg.

Leslie


\_\_\_\_\_ Ft. from N. Line

\_\_\_\_\_ Ft. from S. Line

\_\_\_\_\_ Ft. from E. Line

\_\_\_\_\_ Ft. from W. Line

C NE NW

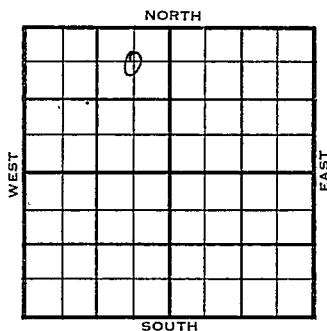

1956

ELEVATION

2685'

REPORT

4-4

Loc.

6-13

Comm. 4-2-56

8 5/8" @ 1455 w/600

csg. 4580,

Marm. 5235',

Ce. 5450',

Ataka 5650',

Mw grp 5770',

crd 5770-72, full rec. crd. 5772-5813

Fl rec. Mw sd. 5788

crd. 5813-47, full rec. Miss. 5827',

5 1/2" @ 5845 w/200

CO 5839' 156// 5799-5825

Tst ssg to frac,

ga 1.823 mcf / 3 1/2 boph, 7 hrs.

2" tbg to 5824

SI

Open flo, 1,500 mcf / Dist.

sip 1650

Log: L. 4591', Mw sd. 5788',

TD 5847'

**COMPLETED**



County Meade Elev. 1600  
 Sec. 3 Twp. 31 Rge. 30W  
 Company James Donoghue  
 FarmName W. H. Klein No. 1

TOPS	DEPTH	LOG	DATUM
Anh			
Tp.			
H.			
Tr.			
Dg.			
Bl.			
L.		4591	
K.C. <u>Marm</u>		5257	
B.K.C.			
Ce.		5446	
C. <u>Atoka</u>		5655	
M. <u>MW 9P</u>		5770	
M. <u>" 5d</u>		5788	
K. <u>Miss</u>		5826	
Mz.			
Mo.			
V.			
S.			
S.			
A.			
R.			
PE.			
G.			
TD.	<u>5847</u>		

Loc. in Sec. C 100 W  
 Geol. \_\_\_\_\_  
 Contr. Socket Drils  
 Pool Leslie

0  
**COMPLETE**  
 JUN 13 '56

Date Comm. Tex DHM  
 Location APR 11 '56 4-2-56 85/8  
1455/600 @ 3237 APR 18 '56 @ 4635  
APR 25 '56 @ 5505 MAY 2 '56 659 4580  
Marm 5235 CB 5450 Atoka  
5650 MW 9P 5770 cnd 5770-72  
Full rec cnd 5772-5813 F/Rec  
MW 5d 5788 cnd 5813-47 Full Rec  
Miss 5827 MAY 9 '56 5 1/2 @ 5845/200  
CB 5839 156/5799-5825 1/2

1st SSE to Frac MAY 16 '56 ga

1,823 MCF + 3 1/2 Boph 7 hrs

2<sup>nd</sup> T69 to 5824 MAY 23 '56 MAY 29 '56

JUN 6 '56

JUN 13 '56

Open flo

1,500 MCF

+ Dist

SIP 1650