

KANSAS

Seward


Section 3 Township 34 Range 34WWell No. 1 WilesCompany Panhandle Eastern

Hugoton

NORTH

WEST

EAST

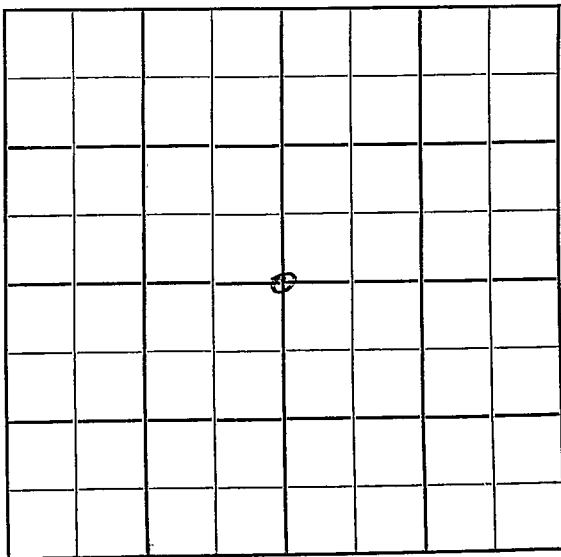

SOUTH

Seward



Sec. 3 Twp. 34 R. 34W

Well No. #1 Wiles Farm

Panhandle Eastern Company

Hugoton Pool (Moran, Cont.)

NORTH


2768' Ft. from N. Line

_____ Ft. from S. Line

2540' Ft. from E. Line

_____ Ft. from W. Line

C Sec.

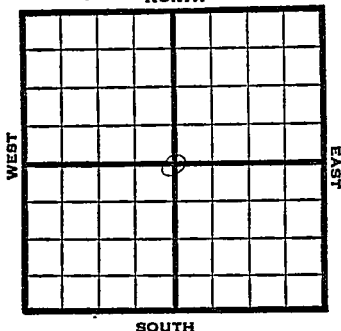

1949

Elv 2919'

R E P O R T

10/19

10" @ 680'
Drlg. 1650'

10/26

TD 2609'
7" @ 2597'

11/1

"

11/9

191' of 5" Perf Liner @ 2757'
TD 2757'

11/23

TD 2757'
7"@ 2597'
191' of 5" Perf Liner @ 2757'
20000 acid
28,607,000 Gas
415# R Pr.

Comp

COMPLETED

Map No. _____ Sec. 3 Twp. 34 R. 34W

Well No. 1 Wiles

Panhandle Eastern Company

Moran Contractor

**FIRST REPORT
SECTION PLAT**


C Sec.

2768 Ft. from N. Line

_____ Ft. from S. Line

2540 Ft. from E. Line

_____ Ft. from W. Line

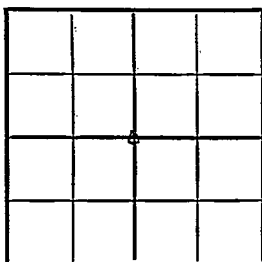

Seward County

Location _____

Rig up _____

Drilling and Remarks:

10" @ 680

dr lg. 1650

RECORD

Cased _____ in., _____ ft.

Sand _____

Gas _____

Oil _____

Total Depth _____

PRODUCTION

1st 24 hrs. Nat. _____

1st 24 hrs. after shot _____

Gas _____ Cu. Ft.

Dry Hole _____

Abandoned _____

Date

OCT 19 1949

S. I. LEWIS Scout

Map No. _____ Sec. 3 Twp. 34 R. 34W

Well No. 1 Wiles

Panhandle Eastern Company


Complete (Gas) Contractor
C Sec. E1. 2719
SECTION PLAT

2768 Ft. from N. Line

_____ Ft. from S. Line

2540 Ft. from E. Line

_____ Ft. from W. Line

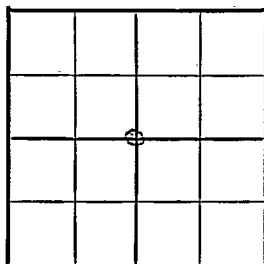

Seward County

Location _____

Rig up _____

Drilling and Remarks:

1" C 2577

19 1/2" 15" Pipe/liner

C 2757

2000000000

28,607,000 lbs

24157 R/A

RECORD

Cased _____ in., _____ ft.

Sand _____

Gas _____

Oil _____

Total Depth 2757

PRODUCTION

1st 24 hrs. Nat. _____

1st 24 hrs. after shot _____

Gas _____ Cu. Ft.

Dry Hole _____

Abandoned _____

Date

NOV 23 1949 19

S. J. LEWIS Scout