


DX 78-1

Morton KANSAS

Section 3 Township 34 Range 43 W

Well No. # 1 Oberly

Company Panhandle Eastern

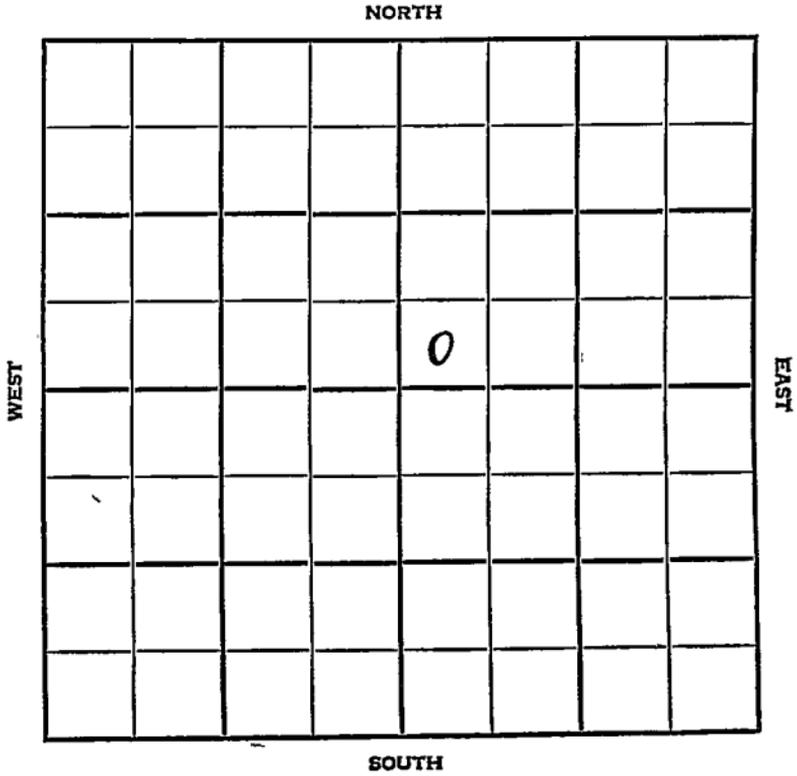

Morton KANSAS


SEC.	TWP.	R.
3	34	43W

WELL NO. 1 Oberly FARM
 COMPANY Panhandle Eastern

CONTRACTOR Garvey

Greenwood Pool

_____ Ft. from N. Line
 330 _____ Ft. from S. Line
 _____ Ft. from E. Line
 330 _____ Ft. from W. Line

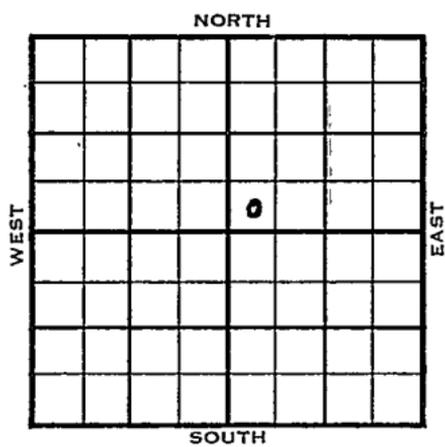

SW SW NE

	ELEVATION	REPORT
1955	3623'	

1/26 Spud 1-21-55
 10" @ 657'
 Drlg. 1705'

3/30 Spud 1-21-55 Gas well TD 3250
 10" @ 657 DST 2895-2970 open 1 hr
 gas in 5 min, 314,000 CFG 620,000 CFG
 55 min, rec 650' HGCM, 460#
 DST 3143-75 open 1 hr rec 170' gas,
 70' SG & SWCM. TD 3250 7" @ 3249
 32/3198-3206 20/3188-93 12/3177-80
 16/3157-61 44/3137-48 1000 A CO
 48/3130-42 1000 A 28/3115-22
 56/2998-3012 1000 A 440,000 CFG
 4000 A Log tops: Waub. 2664'
 Top 2895' Lans 3131'
 24/2963-69 52/2941-54 40/2924-34
 28/2909-16 2,900,000 CFG 5000 A
 6,940,000 CFG SP 2900 10,258,000
 CFG SP 2900 56/2872-86
 5,100,000 CFG 16/2872-76 20/865-70
 24/2847-53 16/2838-42 36/2824-33
 SP 2860 CO to 2900 1000 A 6,397,000
 CFG 4000 A CO to 3250 SP 2855
 9,300,000 CFG SP 3250 9,513,000 CFG
 Comp. 14,306,000 CFGPD 427/2#

COMPLETED

JAN 31 1955

Scout Cards	10
Land Small Map	
Land Wall Map	5
Tracings	
France Map	
Pierce Map	
Misc.	

Scout Cards
 Land Small Map
 Land Wall Map
 Tracings
 France Map
 Pierce Map
 Misc

mm
5

APR 1 1955

Comp. 14,306,000 ctd
 SP 3250 9,513,000 ctd
 4000 A CO to 3250 SP 2855
 CO to 2900 1000 A 6,397,000 ctd
 16/2838-42 36/2824-33 SP 2860
 16/2872-76 20/2865-70 SP 2871
 SP 2900 56/2872-86 5,100,000 ctd

Drig. Date