
DX 78-1 MORTON

KANSAS

Section 3 Township 34 Range 42W

Well No. 1 Renfrew

Company Panhandle Eastern

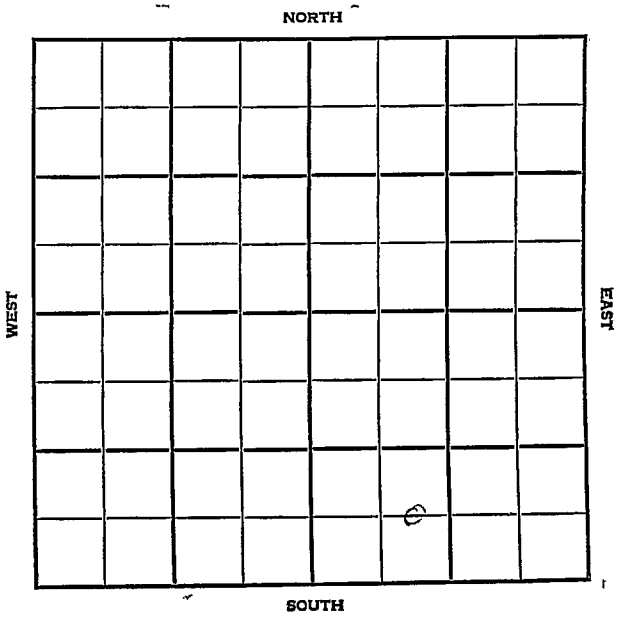

Morton KANSAS

SEC.	TWP.	R.
3	34	42W

WELL NO. 1 Renfrew FARM

COMPANY Panhandle Eastern

CONTRACTOR Garvey

Greenwood Pool


_____ Ft. from N. Line

680 Ft. from S. Line

1468 Ft. from E. Line

_____ Ft. from W. Line

C E/2 SW SE

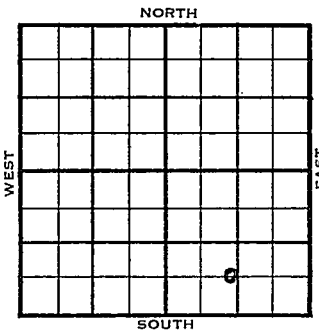

	ELEVATION	REPORT
1955	3410'	
3/30		Spud 3-24-55 10" @ 569'
4/20		Spud 3-24-55 Gas well TD 3260 10" @ 569 Waub. 2611 Top 2834 Lans 3083 TD 3260 7" @ 3260 CO 20/3165-70 16/3155-59 28/3141-48 16/3119-23 40/3102-12 32/3090-98 500,000 CFG 2000 A 4,635,000 CFG SP 3085 40/3047-57 16/3027-31 64/2917-33 24/2898-2904 16/2877-81 16/2866-70 36/2842-51 2000 A 9,362,000 CFG 4000 A 13,800,000 CFG Comp. 27,344,000 CFGPD 425# COMPLETED

DX-78

FORM 275 FOR SALE BY KANSAS BLUE PRINT CO.


County Morton State Kansas

Sec. 3 (Blk. / Twp.) 34 (Sur. / Rge.) 42W Map No.

Operator Panhandle Eastern

Well No. 1 Farm Renfrew

Elev. Location C E½ SW SE

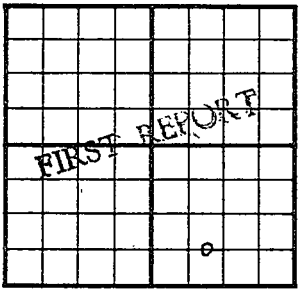

680 Ft. From S Line SE

1468 Ft. From E Line Quarter

1st. Report MAR 3 0 1955

Completion

Remarks

Garvey - Contr.

Spudding Date 3-24-55

Drlg. Data Greenwood Pool

10" @ 569

FABEN GILSTRAP

FORM 275 FOR SALE BY KANSAS BLUE PRINT CO.


County Morton State Kansas

Sec. 3 (Blk. / Twp.) 34 (Sur. / Rge.) 42W Map No.

Operator Panhandle Eastern

Well No. 1 Farm Renfrew

Elev. 3410 Location C E½ SW SE

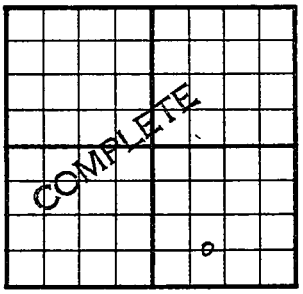

680 Ft. From S Line SE

1468 Ft. From E Line Quarter

1st. Report

Completion APR 2 0 1955

Remarks Greenwood Pool

Garvey - Contr.

Spudding Date 3-24-55

Drlg. Data Gas well TD 3260

10" @ 569 Waub. 2611 Top. 2834

Lans. 3083 TD 3260 7" @ 3260 CO

20/ 3165-70 16/ 3155-59 28/ 3141-48

16/ 3119-23 40/ 3102-12 32/ 3090-98

500,000 cfg 2000 A 4,635,000 cfg

SP 3085 40/ 3047-57 16/ 3027-31

64/ 2917-33 24/ 2898-2904 16/ 2877-81

16/ 2866-70 36/ 2842-51 2000 A

9,362,000 cfg 4000 A 13,800,000 cfg

Comp. 27,344,000 cfgpd 425#

FABEN GILSTRAP