




Stevens

Form 252A-5M-11-29-38055

Map No. KANSAS Sec. 3 Twp. 34 R. 39<sup>w</sup>

Well No. 3- Armstrong Farm  
Argus Gas Company

NORTH

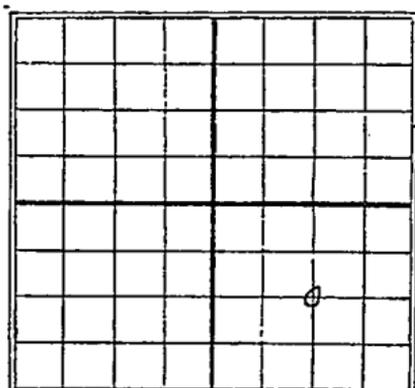

SOUTH

\_\_\_\_\_ Ft. from N. Line

1320 Ft. from S. Line

1320 Ft. from E. Line

\_\_\_\_\_ Ft. from W. Line

1930

Date	REPORT
<u>4/30</u>	<u>Loc.</u>
<u>5/7</u>	<u>—</u>
<u>5/14</u>	<u>Spud 200'</u>
<u>5/21</u>	<u>Drilg. 622'</u>
<u>5/28</u>	<u>" 1865'</u>
<u>6/4</u>	<u>" 2282'</u>
<u>6/11</u>	<u>Point 2554'</u>
<u>6/18</u>	<u>—</u>
<u>6/25</u>	<u>Card 2554-2903</u>
	<u>TD 2903</u>
	<u>7 M Gas</u>
	<u>Comp.</u>

Map No.                      Sec. 3 Twp. 24 R. 29 W

Well No. 3 Armstrong

Argus Gas Company

Contractor

**SECTION PLAT**

..... Ft. from N. Line

1820 Ft. from S. Line

1820 Ft. from E. Line

..... Ft. from W. Line


**FIRST REPORTS**

Location                     

Rig up                     

Drilling and Remarks:

**RECORD**

Cased..... in., ..... ft.

Sand.....

Gas.....

Oil.....

Total Depth.....

**PRODUCTION**

1st 24 hrs. Nat.....

1st 24 hrs. after shot.....

Gas..... Cu. Ft.

Dry Hole.....

Abandoned.....

Date

APR 30 1930

S. J. LEWIS Scout

Map No. **KANSAS** Sec. **C3** Twp. **34** R. **39W**

Well No. **3 Armstrong**

**Argus Gas** Company

Contractor

**SECTION PLAT**

..... Ft. from N. Line  
**1320** Ft. from S. Line  
**1320** Ft. from E. Line  
 ..... Ft. from W. Line


**COMPLETED**

Location.....  
 Rig up.....  
 Drilling and Remarks:  
  
**7M Gas**

**RECORD**

Cased..... in., ..... ft.  
 Sand **2554 - 2903**  
 Gas.....  
 Oil.....  
 Total Depth **2903**

**PRODUCTION**

1st 24 hrs. Nat.....  
 1st 24 hrs. after shot.....  
 Gas..... Cu. Ft.  
 Dry Hole.....  
 Abandoned.....

Date **JUN 25 1930** **S. J. LEWIS** Scout