


Section 3 Township 34 Range 41W

Well No. #1 Eagley (B)

Company Cities Service Oil

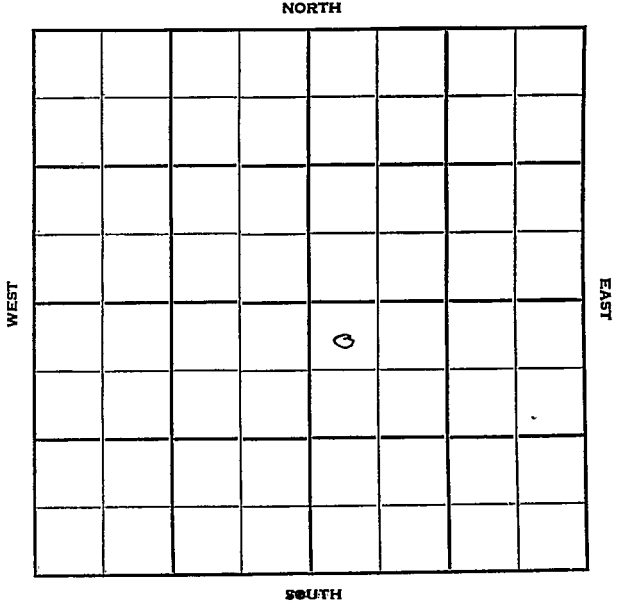

Sec. 3 Twp. 34 R. 11W

Well No. #1 Eagley (B)  Farm

Cities Service Oil Company

Contractor


225 Ft. from N. Line

..... Ft. from S. Line

..... Ft. from E. Line

225 Ft. from W. Line

NW NW SE

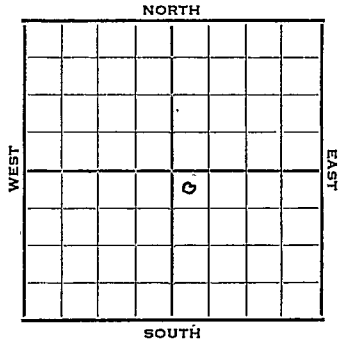

1952 Elev. 3385' REPORT

3/5 Location  
 3/12 8" @ 313 Drlg. 1360'  
 3/19 Her 2120' Up Krider 2142' Lo Krider  
 2165', Winfield 2214', Up Ft. 2272'  
 RTD 2330' 5" @ 2328' CO to 2301'  
 40/2244-52 30/2224-30 30/2214-20  
 5500 A  
 4/2 Spud 3-6-52  
 Gas Well TD 2330  
 8" @ 313  
 Her. 2120 Kri, 2142  
 Win. 2214 Ft. Riley 2272  
 TD 2330 5" @ 2328 CO to 2301  
 40/ 2244-52 30/ 2224-30  
 30/ 2214-20 50/ 2178-88  
 40/ 2166-74 30/ 2158-84  
 50/ 2138-48 17500 A  
 Comp. 5,900,000 gas

**COMPLETED**

County **Morton** State **Kansas**Sec. **3** (Blk. Twp.) **34** (Sur. Rge.) **41W** Map No.Operator **Cities Service Oil**Well No. **1** Farm **Eagley (B)**Elev. Location **NW NW SE**


FIRST REPORT

**225** Ft. From **N** Line **SE****225** Ft. From **W** Line QuarterIst. Report **MAR 5 1952**

Completion

Remarks

Spudding Date

Drig. Data

Location

**J. G. McGEHEE**

County Morton State Kansas

Sec. 3 (Blk. 34) (Sur. 41W) (Twp.) (Rge.) Map No.

Operator Cities Service Oil

Well No. 1 Farm Hagley "B"

Elev. 3385 Location NW NW SE


225 Ft. From N Line SE

225 Ft. From W Line Quarter

Ist. Report

Completion APR 2 1952

Remarks

Spudding Date 3-6-52

Drilg. Data Gas well TD 2330

8" @ 313 Her. 2120 Kri. 2142

Win. 2214 Ft. Riley 2272 TD 2330

5" @ 2328 CO to 2301 40/ 2244-52

30/ 2224-30 30/ 2214-20 50/ 2178-88

40/ 2166-74 30/ 2158-64 50/ 2138-48

17500 A Comp. 5,900,000 gas

*[Handwritten scribbles]*

**J. G. McGEHEE**