


Give All Information Completely
Make Required Affidavit
Mail or Deliver Report to:
Conservation Division
State Corporation Commission
212 No. Market
Wichita, Kansas

WELL PLUGGING RECORD

NORTH

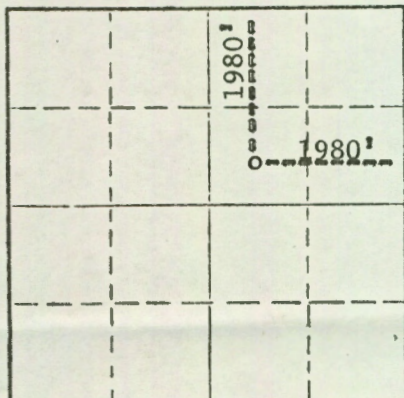

Locate well correctly on above
Section Plat

Meade County. Sec. 29 Twp. 34S Rge. 30W (E) (W)

Location as "NE/CNWxSWx" or footage from lines C/SW/NE

Lease Owner Bruce Calder

Lease Name Evans Well No. 1-29

Office Address P.O. Box #7, Spearman, Texas 79081

Character of Well (completed as Oil, Gas or Dry Hole) Dry Hole

Date well completed 6/28 19 69

Application for plugging filed (Called Corp. Comm) 6/29 19 69

Application for plugging approved 6/29 (By Tele. Conv.) 19 69

Plugging commenced 6/29 19 69

Plugging completed 6/29 19 69

Reason for abandonment of well or producing formation Dry Hole

If a producing well is abandoned, date of last production None 19

Was permission obtained from the Conservation Division or its agents before plugging was commenced? Yes

Name of Conservation Agent who supervised plugging of this well Edgar Eves

Producing formation none Depth to top Bottom Total Depth of Well 6460 Feet

Show depth and thickness of all water, oil and gas formations.

OIL, GAS OR WATER RECORDS

CASING RECORD

FORMATION	CONTENT	FROM	TO	SIZE	PUT IN	PULLED OUT
Tornonto	Oil & Water	4401	4443	8-5/8"	1423	None
Lansing	Oil & Water	4549	4558			
K.C.	Oil & Water	4849	4856			
Keating	Oil & Water	5603	5632			
UpperMorrow	Oil & Water	5799	5870			
Chester	Oil & Water	6176	6209			

Describe in detail the manner in which the well was plugged, indicating where the mud fluid was placed and the method or methods used in introducing it into the hole. If cement or other plugs were used, state the character of same and depth placed, from surface feet to 900 feet for each plug set.

Set 35 sack cement plug 900-800
15 sack cement plug 45-zero
Welded on cap.

(If additional description is necessary, use BACK of this sheet)

Name of Plugging Contractor Sage Drilling Co., Inc.

Address 500 Bitting Building, Wichita, Kansas

STATE OF Texas, COUNTY OF Hansford, ss.

(employee of owner) or (owner or operator) of the above-described well, being first duly sworn on oath, says: That I have knowledge of the facts, statements, and matters herein contained and the log of the above-described well as filed and that the same are true and correct. So help me God.

ORIGINAL SIGNED BY

(Signature) EVERETT R. TRACY

P.O. Box #7, Spearman, Texas 79081

(Address)

SUBSCRIBED AND SWORN TO before me this 3rd day of July, 1969

Hansford County, Texas Notary Public.

My commission expires June 1, 1971