

LAUGHLIN-SIMMONS & CO. OF KANSAS, INC.
OILWELL ELEVATIONS AND LOCATIONS
2048 LULU STREET (316) AM 4-6553
WICHITA, KANSAS 67211

6-16-66

DATE

MEADE COUNTY 32 S 34 E 30 W

C NE NE LOCATION

HORIZON OIL & GAS OPERATOR

1 NO.

ADAMS


FARM

ELEVATION 2623 Gr

MR. W. R. ATKINSON
Box 1142
LIBERAL, KANSAS

SCALE: 2" = 1 Mile

Loc falls in very rough pasture land & is marked with a short & a tall red topped w/ pink & white flagging.

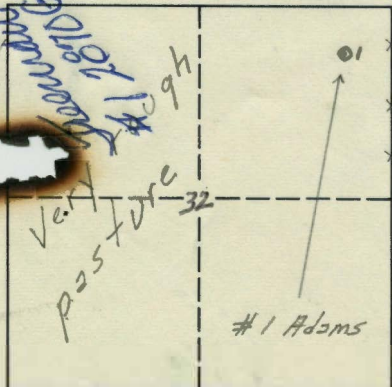

MINIMUM STAKING CHARGE:

\$30.00

EXTRA TIME & MILEAGE:

7.50

ELEVATION CHARGE:

20.00

TOTAL:

\$57.50

Thanks

OK Tammill

L-S ENGINEER