

Barber


KANSAS

SECTION 30 TOWNSHIP 34 RANGE 13W

WELL NO. #1 Achenbach

COMPANY Time Petr.

NORTH C E  $\frac{1}{2}$  NW

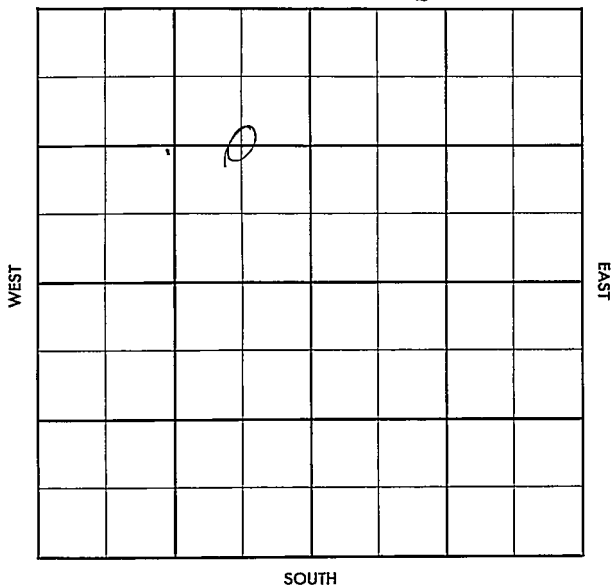



County Barber Elev. 1692  
 Sec. 30 Twp. 34 Rge. 13W  
 Company Time Petroleum  
 Farm Name Achenbach No. 1

TOPS	DEPTH	LOG	DATUM	Loc. in Sec.
Anh.				C E $\frac{1}{2}$ NW
Tp.				
H.				
Tr.				
Dg.				
Bl.				
L.				Geol.
K.C.	4208			Contr.
BXC.				Kirpatrick
Ce.				
C.				Pool
M.	4795			Blunk Ext.
M.				
K.				
Mz.				
Me.				
V.				
S.				
S.				
A.				
R.				
PE.				
G.				
TD.	4820			

APR 3 1957
o
COMPLETE

Date Comm.

Location SEE LOG / FRAC 13W FRAC 13W2-18-57 10 3/4 309 1250FRAC 13W 3336 FRAC 13W DST 4800-15FRAC 13W (120) Gas (2) 650 MCF, 35'MFP 120-140 BHP 1900-1850(30)KTD 4820 5 1/2" 4800 WACTFRAC 13W CO 4820 ga 1 MILL CFG FRACga 1 1/2 MILL CFG FRAC ga 7 1/2MILL CFG PD + LD SIP 1670

C50 op Flow +st  
8.100 MCFG PD.