


Barber

KANSAS

SECTION 30 TOWNSHIP 34 RANGE 13 W

WELL NO. #1 Blunk

COMPANY Ed Adair & Carter Oil

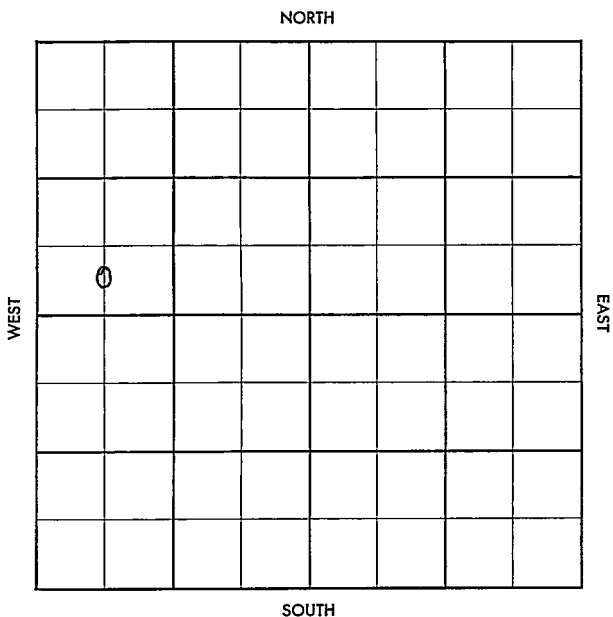

Barber

KANSAS

SEC.	TWP.	R.
30	4 34	13W


WELL NO. 1 Blunk FARM

COMPANY Ed Adair & Carter Oil

CONTRACTOR Co tools

Wildcat

_____ Ft. from N. Line
 _____ Ft. from S. Line
 _____ Ft. from E. Line
 _____ Ft. from W. Line

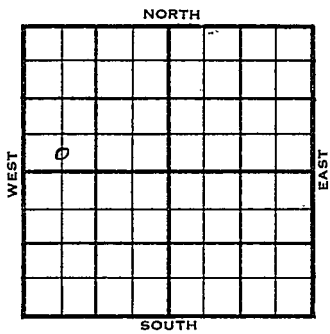

C S $\frac{1}{2}$ SW NW

Alt. - DHM

1955 ELEVATION 1599 DF, 1602 RB REPORT

11/16 Comm 11-9-55
 8" @ 312/266
 Ø 2710

1956

1-11 DST 4120-35 gas in 5 min., 11 mcfg, #
 2000' gassy sw, 1200 #
 DST 4700-17 op 1 hr. rec. 25' mud
 490/20"
 DST 4690-4727 op 1 3/4 hrs., gas in
 90 min. rec. 25' mud, 330/20"
 DST 4727-43 op 2 hrs. gas in 8 min.
 156 mcfg, 180 mcfg in 30 min. rec 45'
 mud.
 DST 4743-53 op 1 1/2 hr. rec 20' mud,
 150/20"
 5 1/2" @ 4727/125
 CO 4753, PB 4743, 300 mcfg, 500 A
 Frac, 3 mmdf,
 Comp. SI gas well
 5,200 mcfgpd.
 Elgin 3821
 H. 3984
 Tr. 4000
 Dg. 4046
 L. 4114
 M. 4712
 M. Dolo. 4727

TD 4753'

COMPLETED

County Barber Elev. _____
 Sec. 30 Twp. 34 Rgs. 13W
 Company Ed Adair & Carter Oil
 FarmName Blunk No. 1

TOPS	DEPTH	LOG	DATUM	Loc. in Sec.
Anh.				<u>C S $\frac{1}{2}$ SW NW</u>
Tp.				
H.				
Tr.				
Dg.				
Bl.				
L.				
K.C.				Geol. _____
B.K.C.				Contr. _____
Ce.				<u>Co. tools</u>
C.				
M.				Pool
M.				<u>Wildcat</u>
K.				
Mz.				
Me.				
V.				
S.				
S.				
A.				
R.				
PE.				
G.				
T.D.				

FIRST REPORT

Date Comm. 11-9-55 Atl. - DHM
8" @ 312/266 drlg. 2710 ~~NOV 19 1955~~
 NOV 16 1955

[Handwritten signature]

NOV 21 1955

Scout Cards	<u>mm^c</u>
Land Small Map	_____
Land Wall Map	_____
Tracings	_____
France Map	_____
Pierce Map	_____
Misc.	_____

1599 DF

County Barber Elev. 1602 RB

Sec. 30 Twp. 34 Rgs. 13W

Company Ed Adair & Carter Oil

FarmName Blunk No. 1

TOPS	DEPTH	LOG	DATUM	Loc. in Sec.
Anh.				C S $\frac{1}{2}$ SW NW
Tp. <u>E 19 in</u>	<u>3821</u>			
H.	<u>3984</u>		<u>2385</u>	
Tr.	<u>4000</u>		<u>2401</u>	
Dg.	<u>4040</u>		<u>2447</u>	
Bl.				
L.	<u>4114</u>		<u>2515</u>	
K.C.				Geol.
B.K.C.				Contr.
Ce.				Co. tools
C.				
M.	<u>4712</u>		<u>3113</u>	Pool
M. <u>Dolo</u>	<u>4727</u>		<u>3128</u>	<u>Wildcat</u>
K.				
Mz.				
Mo.				
V.				
S.				
S.				
A.				
R.				
PE.				
G.				
T.B.	<u>4753</u>			

COMPLETE

Date Comm. 11-9-55 JAN 11 1956

8" @ 312/266 DST 4k20-35 gas in 5 min.

11 mcfg 2000' gassy sw 1200#

DST 4700-17 open 1 hr. rec. 25' mud

490/20" DST 4690-4727 open 1 3/4 hr.

gas in 90 min. rec. 25' mud 330/20"

DST 4727-43 open 2 hr. gas in 8 min.

156 mcfg 180 mcfg in 30 min. rec. 45'

mud DST 4743-53 open 1 1/2 hr.

rec. 20' mud 150/20" 5 1/2" @ 4727/125



JAN 20 1956

R. G.

CO 14753 PB 14743 300 mcfg 500 A
 frag 3 mncf - Comp. SI gas well
 5,200 mcfgpd