


Section 30 Township 34 Range 25W

Well No. #1 T.E. & E.H. Davis

Company Delhi Oil Corp.

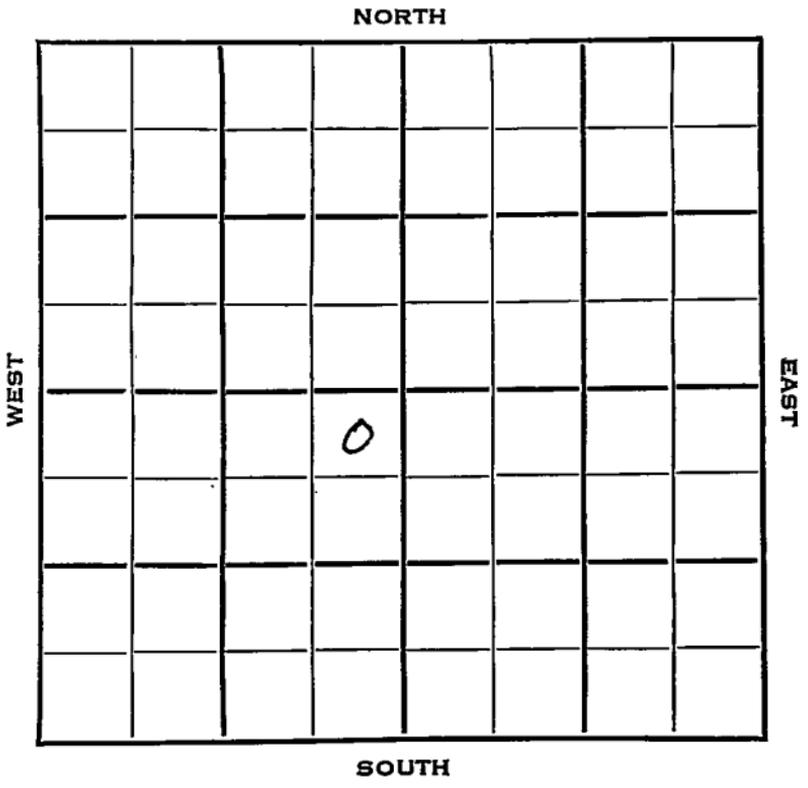

Sec. 30 Twp. 34 R. 25W

Well No. #1 T. E. & E. H. Davis Farm

Delhi Oil Corp. Company


Contractor

330 Ft. from N. Line

_____ Ft. from S. Line

330 Ft. from E. Line

_____ Ft. from W. Line

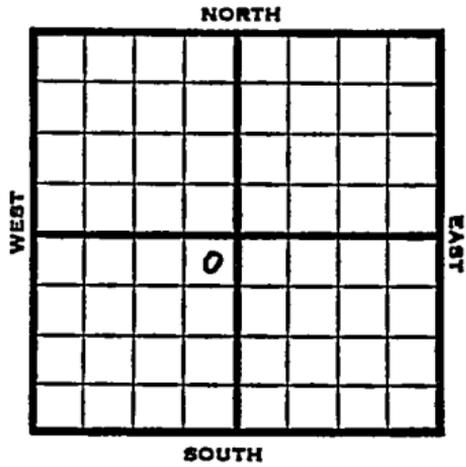

NE NE SW

1953

Elev. 2094' REPORT

8/12

Location

8/19

"

8/26

Lost hole @ 400
Skid Rig

9/2

18" @ 60'
10" @ 563'
Drlg 1112'

9/9

Drlg. 2828'

9/16

7" @ 2654'
Well 1630, Hol 2330, Win 2500, Ft.
Riley 2630'

9/23

Heeb 4370
Drlg.

10/14

D & A

10/28

Spud 8-22-53 D & A TD 6240'
18" @ 60 10" @ 563 7" @ 2654
Well. 1630 Hol. 2330' Win. 2500
Ft. Riley 2630' Heeb 4370'
DST 5771-95 open 1/4 hr. rec 20' mud
80#
DST 5793-5830' open 10 min rec 10'
mud.
DST 5827-70 open 20 min rec 40' mud
2400#

OVER

1953
10/28


DST 5872-5918 open $\frac{1}{2}$ hr rec 30' mud
Lans 4570 Morrow 5733 Chester 5788
St. Gen. 6190'
DST 6155-6240 open 20 min rec 10' mud
2420# D & A

ABANDONED

AUG 14 1953

Scout Cards	40
Land Small Map	
Land wall Map	3
Tracings	
France Map	
Pierce Map	
MISC.	

Drig. Date

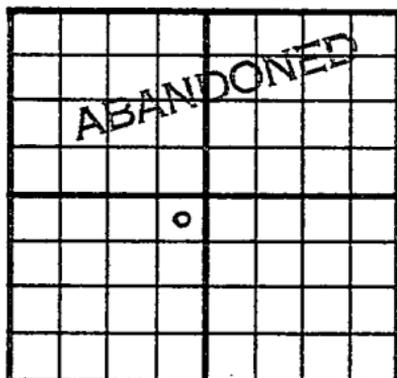County Clark State KansasSec. 30 (Blk. 34) (Sur. 25W) (Twp. 34) (Rge. 25W) Map No.Operator Delhi Oil Corp.Well No. 1 Farm T. E. & E. H. DavisElev. 2094 Location NE NE SW330 Ft. From N Line SW330 Ft. From E Line Quarter1st. ReportCompletion OCT 28 1953RemarksSpudding Date 8-22-53Drilg. Data D & A TD 624018" @ 60 10" @ 563 7" @ 2654Well. 1630 Hol. 2330 Win. 2500Ft. Riley 2630 Heeb. 4370 DST 5771-95open $\frac{1}{2}$ hr. Rec. 20' mud 80#DST 5793-5830 open 10 min. Rec. 10' mudDST 5827-70 open 20 min. Rec. 40' mud2400# DST 5872-5918 open $\frac{1}{2}$ hr. Rec.30' mud Lans. 4570 Morrow 5733Chester 5788 St. Gen. 6190 DST 6155-6240 open 20 min. Rec. 10' mud 2420#D & A

Scout Cards *mm*

Land Small Map

Land Wall Map *33*

Tracings

France Map

Pierce Map

Misc.

NOV 2 1953

Dirg. Data