


Section 30 Township 34 Range 33W

Well No. #1 Kirk "A"

Company Cities Service

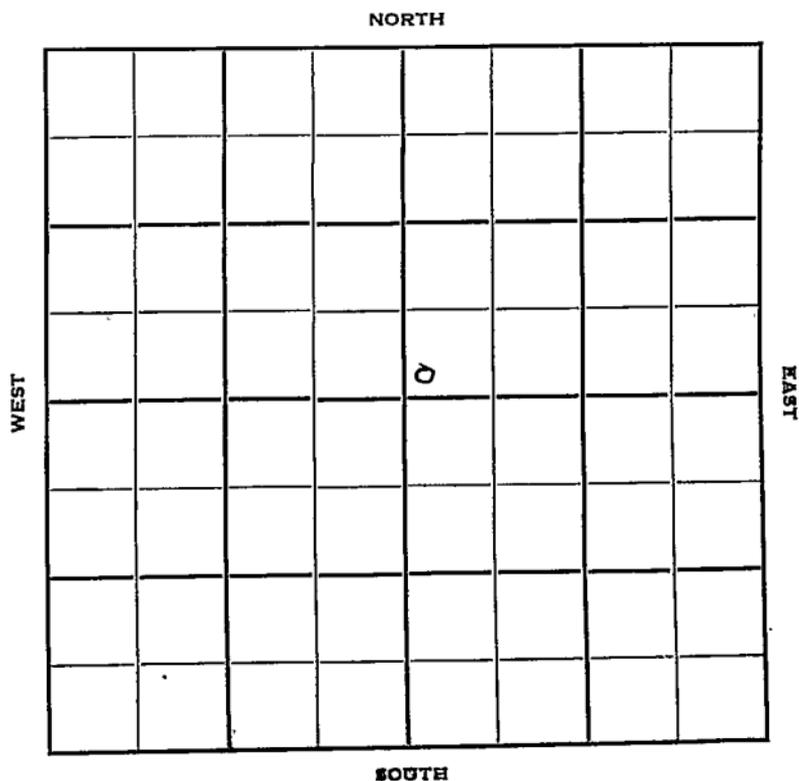

Sec. 30 Twp. 34 R. 33W

Well No. #1 Kirk "A" Farm

Cities Service Company

Hugoton Pool Contractor

Ft. from N. Line

100'


Ft. from S. Line

Ft. from E. Line

100'

Ft. from W. Line

SW NE

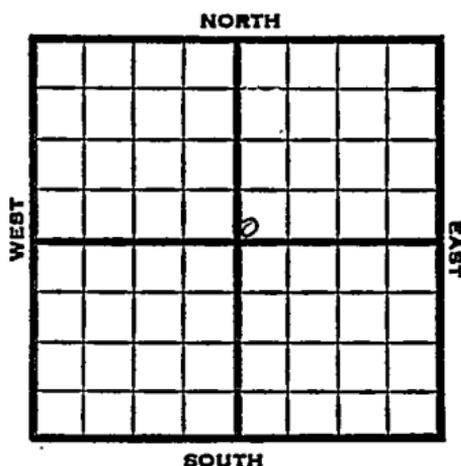

1951 Elev. 2876' REPORT

8/8 Location

10/31

Spud 8-8-51
 Gas Well TD 2764
 8" @ 688
 5" @ 2762
 TD 2764
 Her. 2602 Kri 2628
 Win. 2714
 60/2718-30 3500 A 2,150,000 gas
 2 gwph CO to 2706 20/2698-2702
 180/2660-96 50/2628-38 50/2602-12
 22,000 A Comp. 20,700,000 gas

COMPLETED

County **Seward** State **Kansas**

Sec. **30** (Blk. Twp.) **34** (Sur. Rge.) **33W** Map No.

Operator **Cities Service**

Well No. **1** Farm **Kirk "A"**

Elev. Location **SW NE**

FIRST REPORT					

100 Ft. From **S** Line **NE**

100 Ft. From **W** Line **Quarter**

1st. Report **AUG 8 1951**

Completion

Remarks

Spudding Date

Drlg. Data **Hugoton Pool**

Location

J. E. TYRA

County Seward State Kansas

Sec. 30 (Blk. Twp.) 34 (Sur. Rge.) 33W Map No.

Operator Cities Service

Well No. 1 Farm Kirk "A"

Elev. 2876 Location SW NE

100 Ft. From S Line NE

100 Ft. From W Line Quarter

Ist. Report

Completion OCT 31 1951

Remarks Hugoton Pool

Spudding Date 8-8-51

Drig. Data Gas well TD 2764

8" @ 688 5" @ 2762 TD 2764

Her. 2602 Kri. 2628 Win. 2714

60/ 2718-30 3500 A 2,150,000 gas

2 gwph CO to 2706 20/ 2698-2702

180/ 2660-96 50/ 2628-38 50/ 2602-12

22000 A Comp. 20,700,000 gas

J. E. TYRA