

Morton


KANSAS

SECTION 30 TOWNSHIP 34 RANGE 43 W

WELL NO. #1 Frank H. Scott

COMPANY Stanolind

NORTH

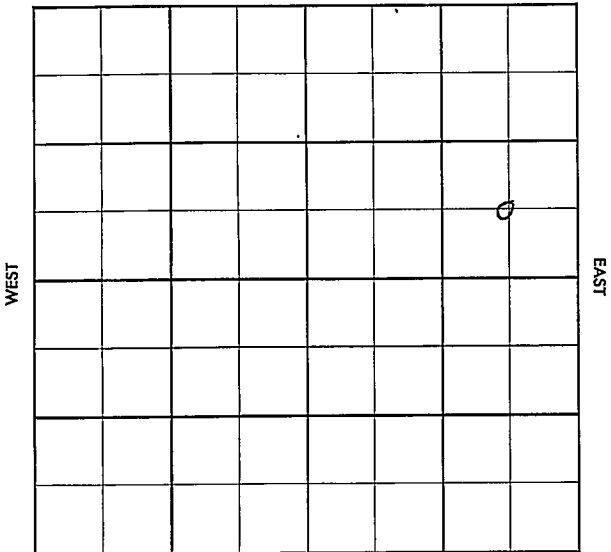

SOUTH

Morton

KANSAS

SEC. 30	TWP. 34	R. 43W
------------	------------	-----------

WELL NO.

#1 Frank H. Scott

FARM

COMPANY

Stanolind

CONTRACTOR

Interstate


Ft. from N. Line

Ft. from S. Line

Ft. from E. Line

Ft. from W. Line

C SE NE

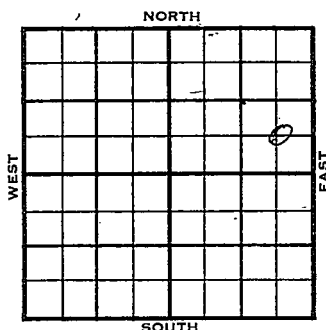

	ELEVATION	REPORT
1955	3508'	
12-28	Location	
<u>1956</u>		
1-25	Comm. 12-31-55 8 5/8" @ 1208/800 DST 3628-54 op 1 hr. rec. 600' muc, 1730/20" DST 4206-27 op 1 hr. rec. 2400' sw 1300/20" DST 4440-80 op 45 min. rec. 10' mud, 70/30" D & A " L. 2953 Marm 3630 Mw. sh. 4108 Puffy sd 4206 TD 4600'	
		ABANDONED

County Morton Elev. _____
 Sec. 30 Twp. 34 Rge. 43W
 Company Stanolind
 Farm Name Frank H. Scott No. 1

TOPS	DEPTH	LOG	DATUM	Loc. in Sec. _____
Anh.				C SE NE
Tr.				
H.				
Tr.				
Dg.				
Bl.				
L.				Geol. _____
K.C.				Contr. _____
B.K.C.				
Ce.				
C.				
M.				
M.				Pool _____
K.				Interstate
Mz.				
Mq.				
V.				
S.				
S.				
A.				
R.				
Pe.				
G.				
T.D.				

FIRST REPORT
 DEC 28 55

Date Comm. _____
 Location _____

[Handwritten signature]

County Morton Elev. 3508
 Sec. 30 Twp. 34 Rge. 43W
 Company Stanolind
 Farm Name Frank H. Scott No. 1

TOPS / DEPTH LOG DATUM

Anh. _____
 T.P. _____
 H. _____
 Tr. _____
 Dg. _____
 BL. _____
 L. 2953
 K.C. _____
 B.K.C. _____
 Ce. Mamm 3630
 C. Mw. sh 4108
 M. Clay sh 4206
 M. _____
 K. _____
 Mz. _____
 Mg. _____
 V. _____
 S. _____
 S. _____
 A. _____
 R. _____
 P.E. _____
 G. _____
 T.D. 4600

Loc. in Sec. _____


C SE NE

Geol. _____

Contr. _____

Pool _____

Interstate

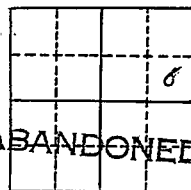Date Comm. 12-31-55

JAN 25 1956

8 5/8" @ 1208/800 DST 3 628-54

open 1 hr. rec. 600' mud 1730/20"

DST 4206-27 open 1 hr. rec. 2400' sw
1300/20" DST 440-80 open 45 min.

rec. 10' mud 70/30"

D & A