


O. W. P. B.

DX 78-1

Morton KANSAS

Section 30 Township 34 Range 43W
Well No. 1 Kansas City Life
Company Stanolind

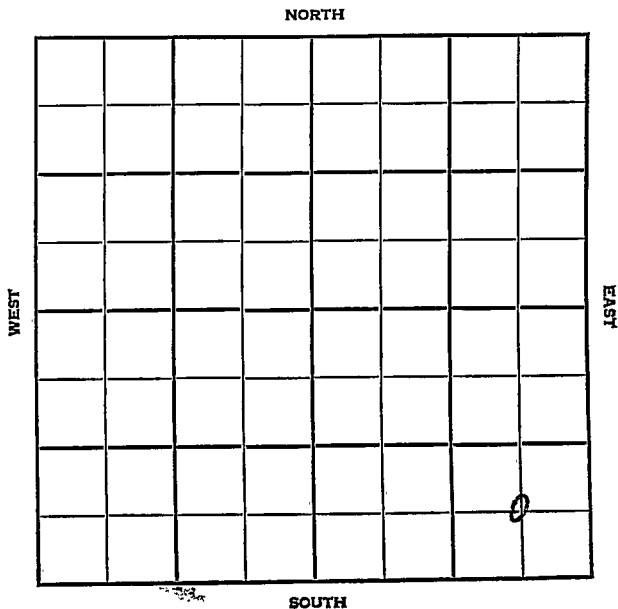

O. W. P. B.

Morton KANSAS

SEC.	TWP.	R.
30	34	113W
WELL NO.		
1 Kansas City Life		FARM
COMPANY		
Stanolind		
CONTRACTOR		

Interstate Pools


_____ Ft. from N. Line

660 _____ Ft. from S. Line

660 _____ Ft. from E. Line

_____ Ft. from W. Line

C SE SE

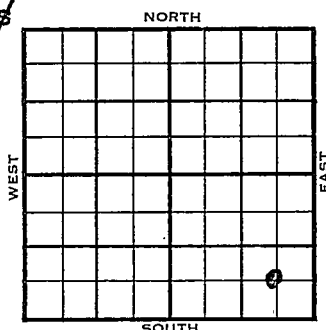

1955

ELEVATION

3519'

REPORT

3/23

Location

7/6

Comm 3-9-55

8 5/8" @ 1224/800 DST 2964-3024 open 1 hr. Rec 300' mw 470/30" DST 4109-58 open 1 hr. Rec 10' mud 0/30" DST 4184-4223 open 1 hr. gas to surface in 3 min. 1,320 mcfg 18 min. Rec. 500' oil 75sw 1140/15" DST 4455-67 open 1 hr. Rec. 15' socm 225/30" DST 4503-26 open 1 hr. Rec 120' msw 60/sw 810/30" DST 4006-29 gas to surface in 12 min. 6,160 mcfg 1/2 hr. @ 4544/750 CO to 4498 24/4454-60 B/1 1/2 gw 12 hr. 250 M-A S/42 boph 3 hr. FU 1300' from surface 3 hr. S/19 boph P/14 boph P/14 boph 6 hr. Comp. 336 bopd

Tops:	Depth	Log	Datum
Tp	2737	2712	
Tr.Morrow	4082		563
L.	2954	2945	
C.Purdy	4453		
M. Keyes	4498		
Miss.	4534		1015
TD.	4545		

OVER

COMPLETED

1955
8/10

O. W. P. B.

Old info. OTD 4545' 5" @ 4544
Was Morrow G Zn prod.

NEW INFORMATION: PB 4250'

Perf 36/4210-16; Fill 2000' oil 1 hr

Flo 25 BO no wtr. 2 hrs.

Flo 174 BO no wtr. 13 hrs.

Phy flo 314 BOPD, no wtr.


Purdy 4182', Morrow 4082', Keyes 4453'

Morrow G. Zone 4452'

FIRST REPORT

COMPLETED

County Morton State Kansas
 Sec. 30 (Blk. 34 (Sur. 43W Map No.
 (Twp.) (Rge.)
 Operator Stanolind
 Well No. 1 Farm Kansas City Life
 Elev. 3519 Location C SE SE

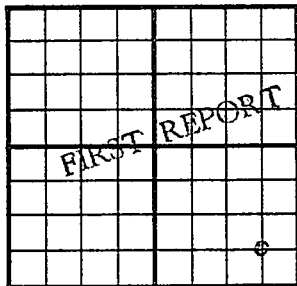

660 Ft. From S Line SE

660 Ft. From E Line Quarter

1st. Report MAR 23 1955

Completion

Remarks

Spudding Date

Drlg. Data

Interstate Pool

Location

FABEN GILSTRAP

MAR 25 1955

Spout Cards	10
Land Small Map	
Land Wall Map	33
Tracings	
France Map	
Pierce Map	
Misc.	

Drig. Data.

County Morton Elev. 3519
 Sec. 30 Twp. 34 Rge. 43W
 Company Stanolind
 FarmName Kansas City Life No. 1

TOPS	DEPTH	LOG	DATUM
Anh.			
Tp.	<u>2737</u>	<u>2712</u>	
H.			
Tr. <u>MORROW</u>	<u>4082</u>		<u>5103</u>
Dg.			
BL.			
L.	<u>2954</u>	<u>2945</u>	
K.C.			
B.K.C.			
Ce.			
C. <u>Purdy</u>	<u>4453</u>		
M. <u>Keyols</u>	<u>4498</u>		
M. <u>ISS</u>	<u>4834</u>		<u>1015</u>
K.			
Mz.			
Mq.			
V.			
S.			
S.			
A.			
R.			
Pe.			
G.			
T.D.	<u>4575</u>		


Loc. in Sec. C SE SE

Geol. _____

Contr. _____

Pool _____

Interstate _____

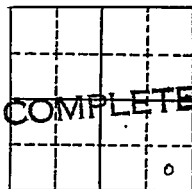

Date Comm. 3-29-55 JUL 6 1955

8 5/8" @ 1224/800 DST 2964-3024

open 1 hr. Rec. 300' mw 470/30"

DST 4109-58 open 1 hr. Rec. 10' mud

0/30" DST 4184-4223 open 1 hr. gas.

to surface in 3 min. 1,320 mcfg 18 min.

Rec. 500' oil 75' sw 1140/15"

DST 4455-67 open 1 hr. Rec. 15' socw

225/30" DST 4503-26 open 1 hr.

OVER

18 1955
JUL 1 1955

Scout Cards	XC
Land Small Map	
Land Wall Map	
Tracings ..	
France Map	
Pierce Map	
Misc.	

Rec. 120' MSW 60' SW 810/30"
DST 4006-29 gas to surface in 12 min.
6,160 mcf $\frac{1}{2}$ hr. Rec. 12' muddy wtr.
1005/30" 5 $\frac{1}{2}$ " @ 4544/750 CO to 4498
24/4454-60 B/1 $\frac{1}{2}$ gw 12 hr. 250 M-A
S/42 boph 3 hr. FU 1300' from surface
3 hr. S/19 boph P/14 boph 6 hr.
Comp. 336 bopd

O. W. P. B.

FORM 513 REV. SUNRAY

County Morton Elev. 43W
 Sec. 30 Twp. 34S Rge. 43W
 Company Stanolind Oil & Gas
 Farm Name K. C. Life No. 1

OWPB

TOPS DEPTH LOG DATUM

Anh.			
Tp. <u>Purdy</u>	<u>4182</u>		
H.			
Tr. <u>Morrow</u>	<u>4082</u>		
Dg.			
Bl. <u>Keyes</u>	<u>4453</u>		
L.			
K.C. <u>Morrow G</u>			
B.K.C. <u>Zone</u>	<u>4452</u>		
Ce.			
C.			
M.			
M.			
K.			
Mz.			
Me.			
V.			
S.			
S.			
A.			
R.			
Pe.			
G.			
T.D.			

Loc. in Sec. C SE SE

Geol.

Contr.

Pool

AUG 10 '55
**FIRST REPORT
 COMPLETE**
 0

Date Comm. Old info - OTD 4545; 5" 4544; was
 Morrow G Zn prod.

New info - PB 4250; perf 36/4210-16;
 fill 2000' oil 1 hr.; flo 25 bo no wtr.
 2 hrs.; flo 17 1/4 bo no wtr. 3 hrs.;
 Phy flo 31 1/4 bopd no wtr.

[Handwritten signature]

Scout Cards	<i>MTM</i>
Land Small Map	
Land Wall Map	
Tracings	
France Map	
Pierce Map	
Misc.	

AUG 16 1955