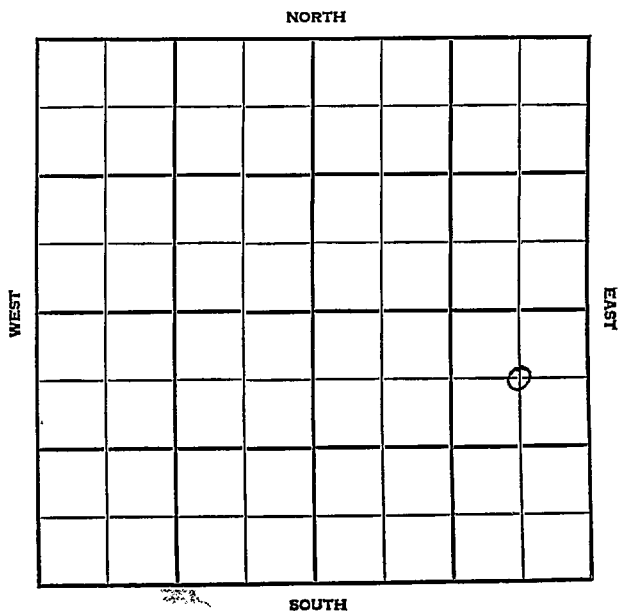


Section 30 Township 31 Range 13 WWell No. #2 Kansas City Life.Company Stanolind

Morton

KANSAS

SEC. 30	TWP. 34	R. 43W
---------	---------	--------

WELL NO.

#2, Kansas City Life

FARM

COMPANY

Stanolind

CONTRACTOR

Interstate


Ft. from N. Line

Ft. from S. Line

Ft. from E. Line

Ft. from W. Line

C NE SE

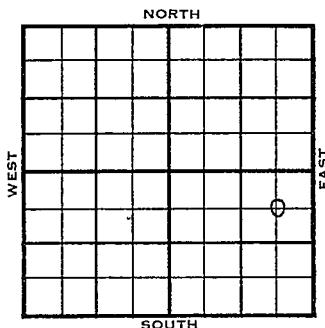

1955

ELEVATION

REPORT

8-24

Comm. 5-24-55

10 3/4" @ 1214/300

DST 3412-70, open 1 hr. Rec. 70' muddy
wtr. 620/30"DST 4012-40, open 1 hr. Rec. 60' drlg.
mud 400/30"DST 4183-4212, Rec. 500' oil 1625'
o & gcs w 1240/30"DST 4444-73, open 1 hr. Rec. 15' mud
685/45#7" @ 4512/750, CO to 4475, 24/ 4462-68
B/ 6 gw 2 hr. 250 A, S/ 11 bo 5 hr.

S/ 245 bo 24 hr., 24/ 4194-98

S/ 45 bo 12 hr., S/ 3 boph 1 hr.

S/ 85 bo 24 hr., 250 A frac

S/ 250 bo 51 bw, S/ 16 bo 163 bw 7 hr.

S/ 32 bo 204 bw 9 hr., PB 4236

B/ dry 24/ 4188-92, B/ 175 gw 24 hr.

S/ 55 gwph, S/ 12 bwph, 8/ 4186-88

S/ 45 gwph 24 hr. 300 A S/ 18 bwph

12 hr. SP 4162, CO to 4475, S/ 10 boph

Comp. 177 bopd.

Tp. 2704, 2708, L. 2931, 2932

K.C. Morrow, 4084, B.K.C. Purdy, 4185,

Ce. Morrow Gsd. 4444, C. Keyes, 4496

FIRST REPORT

COMPLETED

County Morton Elev. _____
 Sec. 30 Twp. 31 Rge. 13W
 Company Stanolind
 Farm Name Kansas City Life No. 2

TOPS	DEPTH	LOG	DATUM	Loc. in Sec.
Anh.				C NE SE
Top	2704	2708		
H.				
Tr.				
Dg.				
BL.				
L.	2931	2932		Geol.
M.				Pool
M.				Interstate
K.				
Mz.				
Ma.				
V.				
S.				
S.				
A.				
R.				
Pe.				
G.				
TD.				

FIRST REPORT
 +
 COMPLETE

Date Comm. 5-21-55

AUG 24 1955

10 3/4" @ 1211/300 DST 3112-70

open 1 hr. Rec. 70' muddy wtr. 620/30"

DST 11012-110 open 1 hr. Rec. 60' drlg.

mud 1100/30" DST 1183-1212 Rec. .

500' oil 1625' o & gcsw 1240/30"

DST 11111-73 open 1 hr. Rec. 15' mud .

685/115# 7" @ 11512/750 CO to 11175

21/ 11162-68 B/ 6 gw 2 hr. 250 A

O.V.E.

SEP 2 1955

Scout Cards 119

Land Small Map

Land Wall Map

Tracings

France Map

Pierce Map

Misc.

Comp. 177-bopd

12 hr. SF 1162 GO to 1175- S/ 10 boph

S/ 15 gwph 21 hr. 300 A S/ 18 bwph

S/ 55 gwph S/ 12 bwph. 8/ 1186-88

B/ dry 21/ 1188-92 B/ 175 gw 21 hr.

S/ 32 bo 201 bw 9 hr. PB 1236

ss/ 250 bo. 51 bw S/ 16 bo 163 bw 7 hr.

1 hr. S/ 85 bo. 21 hr. 250 A frag

21/ 1191-98 S/ 15 bo 12 hr. S/ 3 boph

S/ 11 bo 5 hr. S/ 215 bo 21 hr.