
FORM 51 25M 8-50 WESTERN Seward KANSAS

Section 31 Township 34 Range 33 W

Well No. # 2 Airport

Company Northern Ordnance

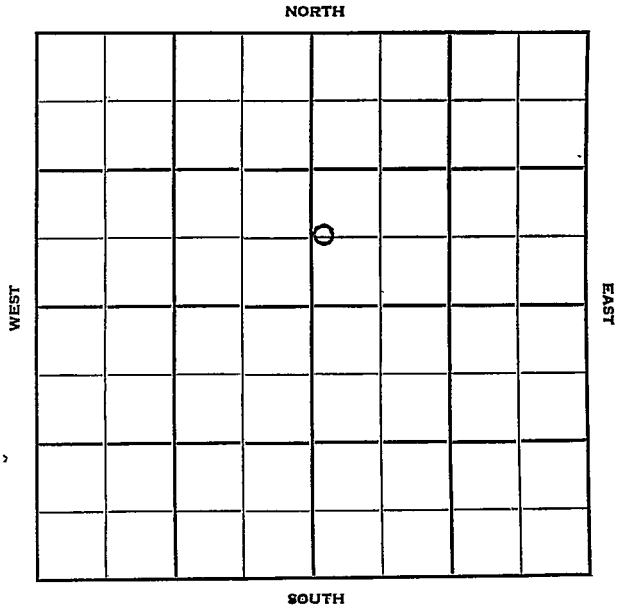

FORM 252-B
10M 11-50 PETROL

Seward KANSAS

Sec. 31 Twp. 34 R. 33W

Well No. #2 Airport Farm

Northern Ordnance Company

Contractor

Hugoton Pool


1800' Ft. from N. Line

Ft. from S. Line

2540' Ft. from E. Line

Ft. from W. Line

SW NE

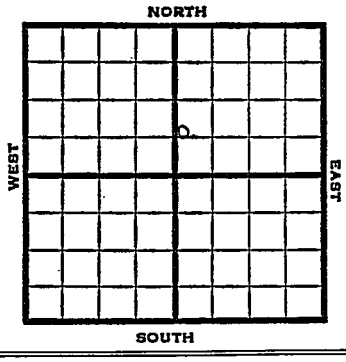

1951	Elev. 2869' REPORT
3/14	Spud 3-9-51 8-5/8" @ 704' Drlg. 1861'
5/29	Spud 3-9-51 Gas Well TD 2690 8-5/8" @ 704 5" @ 2670 TD 2690 Her. 2612' Krider 2668 13,500 A Comp. 11,112,000 gas 410#

COMPLETED

FORM 275 FOR SALE BY KANSAS BLUE PRINT CO.


County Seward State Kansas

Sec. 31 (Blk. Twp.) 34 (Sur. Rge.) 33W Map No.

Operator Northern Ordnance

Well No. 2 Farm Airport

Elev. Location SW NE

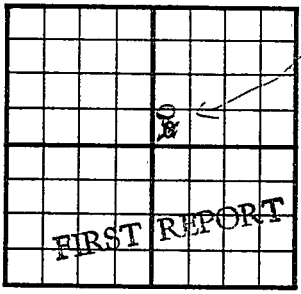

1800 Ft. From N Line NE

2540 Ft. From E Line Quarter

1st. Report MAR 14 1951

Completion

Remarks

Spudding Date 3-9-51

Drlg. Data Hugoton Pool

8 5/8" @ 704 drlg. 1861

J. E. TYRA

FORM 275 FOR SALE BY KANSAS BLUE PRINT CO.


County Seward State Kansas

Sec. 31 (Blk. Twp.) 34 (Sur. Rge.) 33W Map No.

Operator Northern Ordnance

Well No. 2 Farm Airport

Elev. 2869 Location SW NE

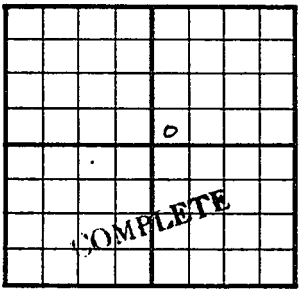

1800 Ft. From N Line NE

2540 Ft. From E Line Quarter

1st. Report

Completion MAY 29 1951

Remarks Hugoton Pool

Spudding Date 3-9-51

Drlg. Data Gas well TD 2690

8 5/8" @ 704 5" @ 2670 TD 2690

Her. 2612 Krider 2668 13500 A

Comp. 11,112,000 gas 410#

J. E. TYRA