


Section 31 Township 34 Range 34-WWell No. #1 DowdyCompany Plains Natural Gas

NORTH

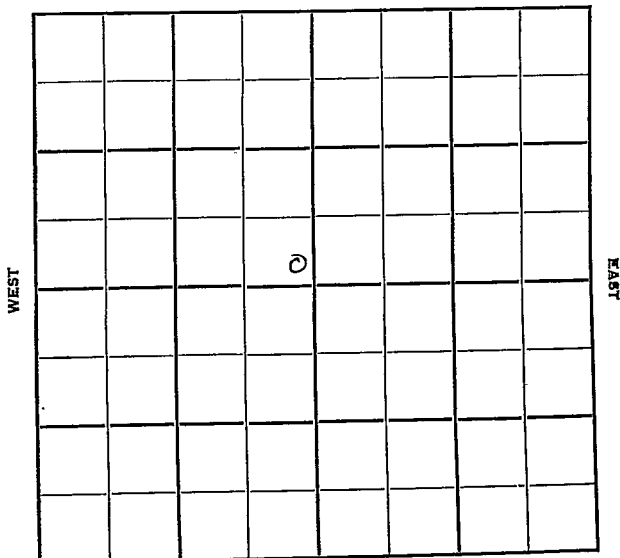

SOUTH

Seward

KANSAS

Sec. 31 Twp. 34 R. 34W

Well No. #1 Dowdy Farm

Plains Natural Gas Company

Hugoton Pool Contractor

 Ft. from N. Line


200' Ft. from S. Line

200' Ft. from E. Line

 Ft. from W. Line

SE NW

Gas Well

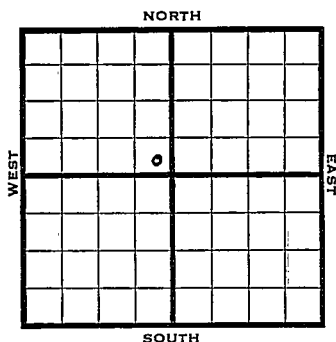

1950

Elev 2946

REPORT

8/9

Location

10/11

Spud 8-13-50

10" @ 606

7" @ 2711

TD 2777

Her 2646

Krider 2578

Win 2758

270/2705-50, 30/2680-85, 72/2652-64

18/2647-50


27,000 total acid

Comp 2,690,000 gas Del

Completed

COMPLETED

County		Seward		State		Kansas	
Sec.	31	(Bk.)	24	(Sur.)	34W	Map No.	
Operator		Plains Natural Gas					
Well No.	1	Farm		Dandy			
Elev.	2946	Location		SE NW			
200 Ft. From S Line		200 Ft. From E Line		Quarter NW			
1st. Report		AUG 9 1950		Completion			
Remarks							
Spudding Date							
Drig. Data		Hugoton Pool					
Location							

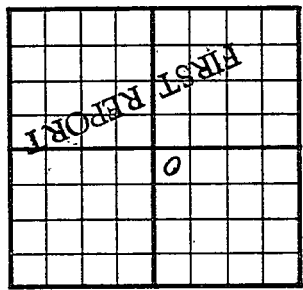

J. E. TYRA

County		Seward		State, Kansas	
Sec.	31	(Blk.)	34	(Sur.)	34W
Operator		Plains Natural Gas			
Well No.		1			
Form		Dowdy			
Elev.		2946			
Location		SE NW			
200 Ft. From S Line		NW			
200 Ft. From E Line		Quarter			
1st. Report					
Completion		OCT 11 1950			
Remarks		Hugoton Pool			
Spudding Date		8-13-50			
Drig. Data		Gas well TD 2777			
10" @ 606		7" @ 2771 TD 2777 Her. 2646			
Kriider 2678		Win. 2758 270/ 2705-50			
30/ 2680-85		72/ 2652-64 18/ 2647-50			
27000 total acid		Comp. 2,690,000 gas Del			

