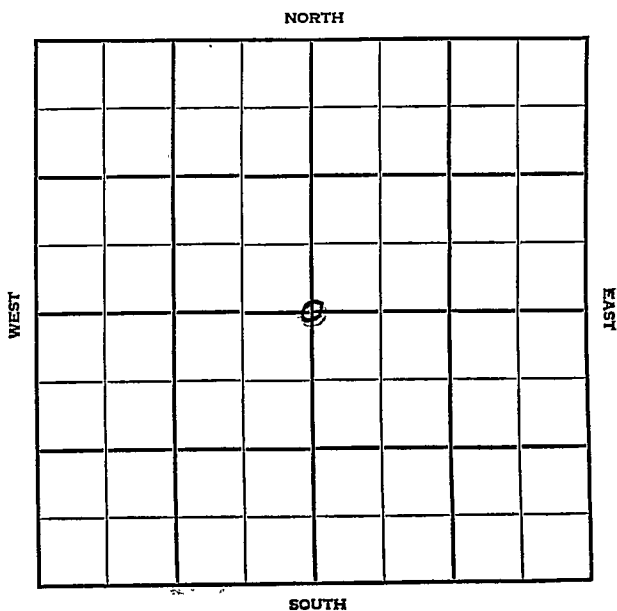


Section 31 Township 34 Range 39WWell No. 1 MingenbackCompany Texas Co.

Morton KANSAS

SEC.	TWP.	R.
31	34	39 W

WELL NO. # 1 Mingenback FARM

COMPANY Texas Company

CONTRACTOR


Stickle Drlg.
 Hugoton Pool

2640 Ft. from N. Line

_____ Ft. from S. Line

2640 Ft. from E. Line

_____ Ft. from W. Line

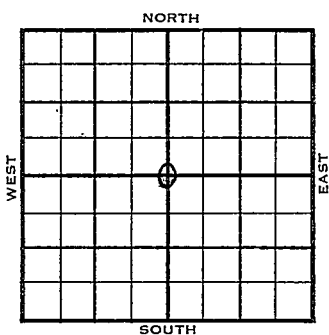

C Section


	ELEVATION	REPORT
1954	3359'	
5/26	Spud 5-20-54 8" @ 513 Drlg. 2386'	
6/2	Her 2608', Kr 2640', Win 2694', Up Ft. 2760' RTD 2875' 5" @ 2814'	
6/9	CO 2805', 66/2772-94', 78/2694-2720', 72/2644-70, 8000A 6 1/2 M	
6/15	Spud 5-20-54 Gas well TD 2815 8" @ 513 Her. 2608 Kr. 2640 Win. 2694 Ft. Riley 2760 TD 2815 5" @ 2814 CO to 2805 66/2772-94 78/2694-2720 72/2644-70 8000 A Comp. 13,585,000 CFGPD	

COMPLETED

Scout Cards MM
 Land Small Map _____
 Land Wall Map 3
 Tracings _____
 France Map _____
 Pierce Map _____
 Misc. _____

MAY 27 1954

Orig. Data

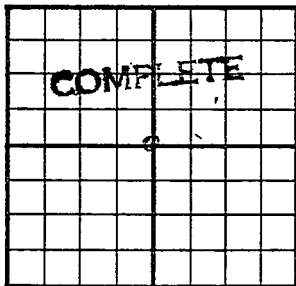County Morton State KansasSec. 31 (Blk. 34) (Sur. 39W) Map No. 34Operator Texas CompanyWell No. 1 Farm MingenbackElev. 3359 Location C Sec.2640Ft. From N Line Sec.2640Ft. From E Line Quarter

1st. Report

Completion JUN 15 1954Remarks Hugoton PoolStickle Drlg. - Contr.Spudding Date 5-20-54Drlg. Data Gas well TD 28158" @ 513 Her. 2608 Kri. 2640Win. 2694 Ft. Riley 2760 TD 28155" @ 2814 CO to 2805 66/ 2772-9478/ 2694-2720 72/ 2644-70 8000 AComp. 13,585,000 cfcpd

J. G. McGEHEE

Scout Cards	mm
Land Small Map	
Land Wall Map	3
Tracings	
France Map	
Pierce Map	
Misc.	

JUN 18 1954

Orig. Data