

KANSAS
WELL COMPLETION REPORT AND
DRILLER'S LOG
State Geological Survey
WICHITA BRANCH

S. 15 T. 34S R. 32 ^{NE} W
 Loc. C NW SW
 County Seward

API No. 15 — 175 — 20,542
 County Number

Operator
 Tucker Production Corporation

Address
 2546 West Main, Littleton, CO 80120


Well No. 1 Lease Name Yeager

Footage Location
 1980 feet from (N) (S) line 660 feet from (X) (W) line

Principal Contractor NRG Drilling Geologist Don Huber

Spud Date 8-4-81 Date Completed 9-16-81 Total Depth 6336 P.B.T.D.

Directional Deviation Oil and/or Gas Purchaser UPG

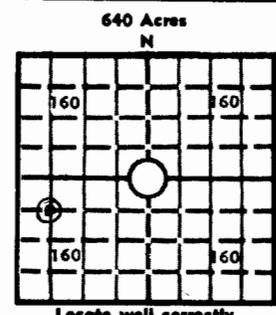

Elev.: Gr. 2755'
 DF _____ KB 2766'

CASING RECORD

Report of all strings set — surface, intermediate, production, etc.

Purpose of string	Size hole drilled	Size casing set (in O.D.)	Weight lbs./ft.	Setting depth	Type cement	Sacks	Type and percent additives
Surface	12-1/4"	8-5/8"	23#	1572'	HLC Class H	600 200	1/4#F; 2% CaCl ₂ 3% CaCl ₂
Production	7-7/8"	4-1/2"	10.5#	6324'	50/50 50/50	50 150	10#/sx Gilsonite 18% salt; 3/4 of 1% CFR-2; 10#/sx G

LINER RECORD

PERFORATION RECORD

Top, ft.	Bottom, ft.	Sacks cement	Shots per ft.	Size & type	Depth interval
			None		

Size	Setting depth	Packer set at

ACID, FRACTURE, SHOT, CEMENT SQUEEZE RECORD

Amount and kind of material used	Depth interval treated
None	

INITIAL PRODUCTION

Date of first production 9-16-81 Producing method (flowing, pumping, gas lift, etc.) Pumping

RATE OF PRODUCTION PER 24 HOURS
 Oil 292 B/D bbls. Gas - MCF Water - bbls. Gas-oil ratio - CFPB

Disposition of gas (vented, used on lease or sold) - Producing interval (s) 6293-6336

INSTRUCTIONS: As provided in KCC Rule 82-2-125, within 90 days after completion of a well, one completed copy of this Drillers Log shall be transmitted to the State Geological Survey of Kansas, 4150 Monroe Street, Wichita, Kansas 67209. Copies of this form are available from the Conservation Division, State Corporation Commission, 245 No. Water, Wichita, Kansas 67202. Phone AC 316-522-2206. If confidential custody is desired, please note Rule 82-2-125. Drillers Logs will be on open file in the Oil and Gas Division, State Geological Survey of Kansas, Lawrence, Kansas 66044.

Operator Tucker Production Corporation

DESIGNATE TYPE OF COMP.: OIL, GAS, DRY HOLE, SWDW, ETC.:

Oil

Well No.

1

Lease Name

Yeager

S 15 T 34 S R 32 ^{XK} W

WELL LOG

Show all important zones of porosity and contents thereof; cored intervals, and all drill-stem tests, including depth interval tested, cushion used, time tool open, flowing and shut-in pressures, and recoveries.

SHOW GEOLOGICAL MARKERS, LOGS RUN, OR OTHER DESCRIPTIVE INFORMATION.

FORMATION DESCRIPTION, CONTENTS, ETC.	TOP	BOTTOM	NAME	DEPTH
No DST's			Wreford Heebner Toronto Lansing Marmaton Morrow Chester St. Gen.	3008 (-242) 4392 (-1626) 4414 (-1648) 4548 (-1782) 5220 (-2454) 5779 (-3013) 5983 (-3217) 6324+ (-3558)

USE ADDITIONAL SHEETS, IF NECESSARY, TO COMPLETE WELL RECORD.

Date Received

Signature

Engineer

Title

10/23/81

Date