


KANSAS CORPORATION COMMISSION

WELL RECORD

26-34-32W

(Mail to Kansas Geological Survey, 4150 Monroe Street, Wichita, Kansas 67209)

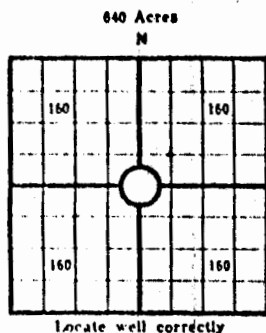

Lease Name: #1 Thompson Well No. _____
 Well Located: Seward County, Kansas
 C E/2 W/2 SW/4 SEC 26 TWP 34S RGE 32W
 Operator: Leben Oil Corporation
 Address: 200 West Douglas, Wichita, Kansas
 Elevation: Ground 2752 D.F. 2761 K.B. 2764
 Type Well: (Oil, gas, dry hole) Dry Hole

Drilling Commenced: Nov. 7 1971 Drilling Completed: Nov. 21 1971
 Well Completed: Nov. 22 1971 Total Depth 6146
 Initial Production: _____

Casing Record

Size: 8 5/8" Set at 1478 Size: _____ Set at _____
 Size: _____ Set at _____ Size: _____ Set at _____

Liner Record

Size: _____ Set from _____ To _____

Cementing

Casing Size	Sacks	Type Cement and Additives
8 5/8"	800	

Perforations

Formation	Perforated Interval and Number Shots

Electric Log Run (Show type log and depths covered)

Welex Radiation-Guard Log 1500-6100

Formation Top Bottom

Council Grove	3031	
Heebner	4407	
Toronto	4433	
Lansing	4568	
K.C.	Not picked	
Hodges	5086	
Marmaton	5262	
Cherokee	5525	
Morrow	5872	
Chester	6095	
Total Depth	6146	

0' - 73'	surface sand
73' - 1065'	sand & red bed
1065' - 1408'	red bed & sand
1408' - 1495'	anhy
1495' - 1978'	red bed
1978' - 2340'	shale - anhy
2340' - 2885'	shale & lime
2885' - 6146'	lime & shale

LOG TOPS DEPTH

CO GR	3032
HEEB	4405
TOR	4429
LANS	4566
KC	4872
HODGES	5082
MRM	5262
CHER	5526
MRW	5872
CHEST	6094
ETD	6146

