
WELL LOG BUREAU—KANSAS GEOLOGICAL SOCIETY 36-34-32W
508 East Murdock, Wichita, Kansas

Company- LANSEHAN
Farm- Wood No. 2

SEC. 36 T. 34 R. 32W
CNW SE

Total Depth. 5455'
Comm. 8-12-53 Comp. 9-12-53
Shot or Treated.
Contractor. Schafer Drlg. Co.
Issued. 4-2-55

County Seward
KANSAS

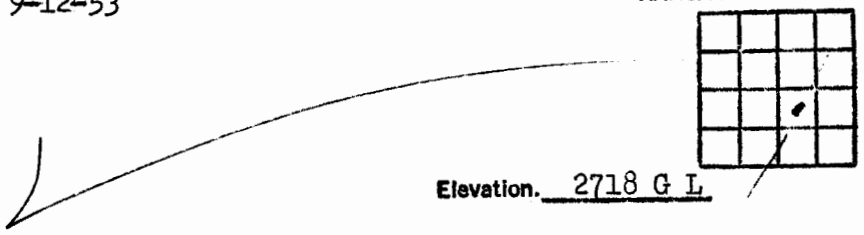

CASING:
13 3/8" 651.5'
8 5/8" 2583.5'

Elevation. 2718 G L

Production. Dry

Figures indicate Bottom of Formations.

sand-clay-shale	611
red bed-shale	883
red bed-sand-shale	1454
red bed-shale	1618
red bed-Anhydrite	1918
Anhydrite-shale	2346
lime	2401
lime-shale	2455
lime-Anhydrite	2598
lime-shale	3605
lime	3718
lime-shale	3774
lime	3840
shale	4120
lime-shale	4273
shale	4348
shale-lime	4456
lime	4539
lime-shale	4582
lime	4659
sdy lime	4681
lime	4721
lime-shale	4772
lime	4827
lime-shale	4937
lime	4955
lime-shale	5007
lime	5236
lime-shale	5274
lime	5345 RTD
lime ?	5455
Total Depth	

TOPS: Scout
Lansing 4421
Marmaton 5220