


Barber KANSAS

SECTION 32 TOWNSHIP 34 RANGE 10 W

WELL NO. # 1 Helen Porterfield

COMPANY Continental Oil Co.

NORTH App. SE NE SW

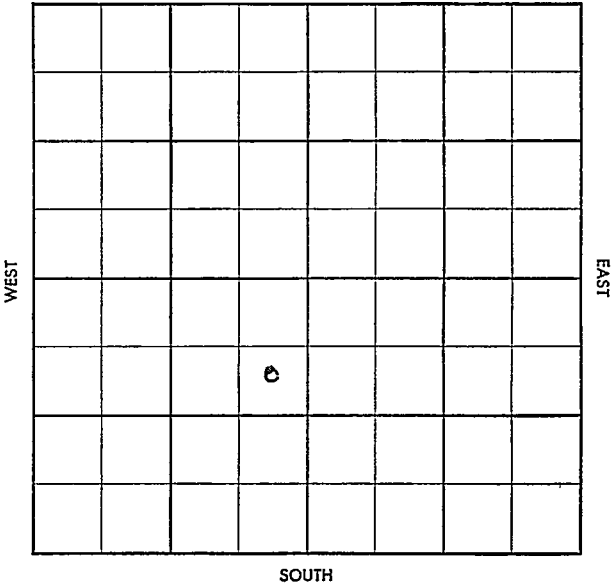

Top Foot  
Co. Facet

5-519-B

County Barber Elev. 1307 RE  
 Sec. 32 Twp. 34S Rge. 10W  
 Company Continental Oil Co. 1302 RB  
 Farm Name Helen Porterfield No. 1

	TOPS	DEPTH	LOG	DATUM
App.	<u>5701</u>	<u>3929</u>		
TP			<u>3612</u>	
H				
T.W.				
Dg.				
B.I.				
B.W.				
K.C.		<u>4196</u>	<u>4194</u>	
B.K.C.				
Ce.				
G.				
M.	<u>Chat</u>	<u>4690</u>	<u>4690</u>	
M.				
KI			<u>4923</u>	
Mz				
Vd		<u>5090</u>	<u>5139</u>	
S.			<u>5223</u>	
S.				
A.				
R.				
PF				
G.				
TD				

Loc. in Sec. ADD.  
SE NE SW

Geol.  
 Contr. Herndon  
Drlg. Tools

Pool  
Wildcat

**ABANDONED**

SEP 24 58

Date Comm. 8/31/58  
8" @ 275 w/200, Drlg 830 Simp Test

SEP 10 58 Ø 3780 SEP 17 58 DST 4693 -

Ø 725 60" 110' gcm FP 22-45

B.H.P. 18 25/30 - 1670 / 45" Ø 4930

SEP 24 58 DST 5092-5105 1hr 4/1ud

FP 22-22 SIP 65-22 TD 5267 Log

D+A